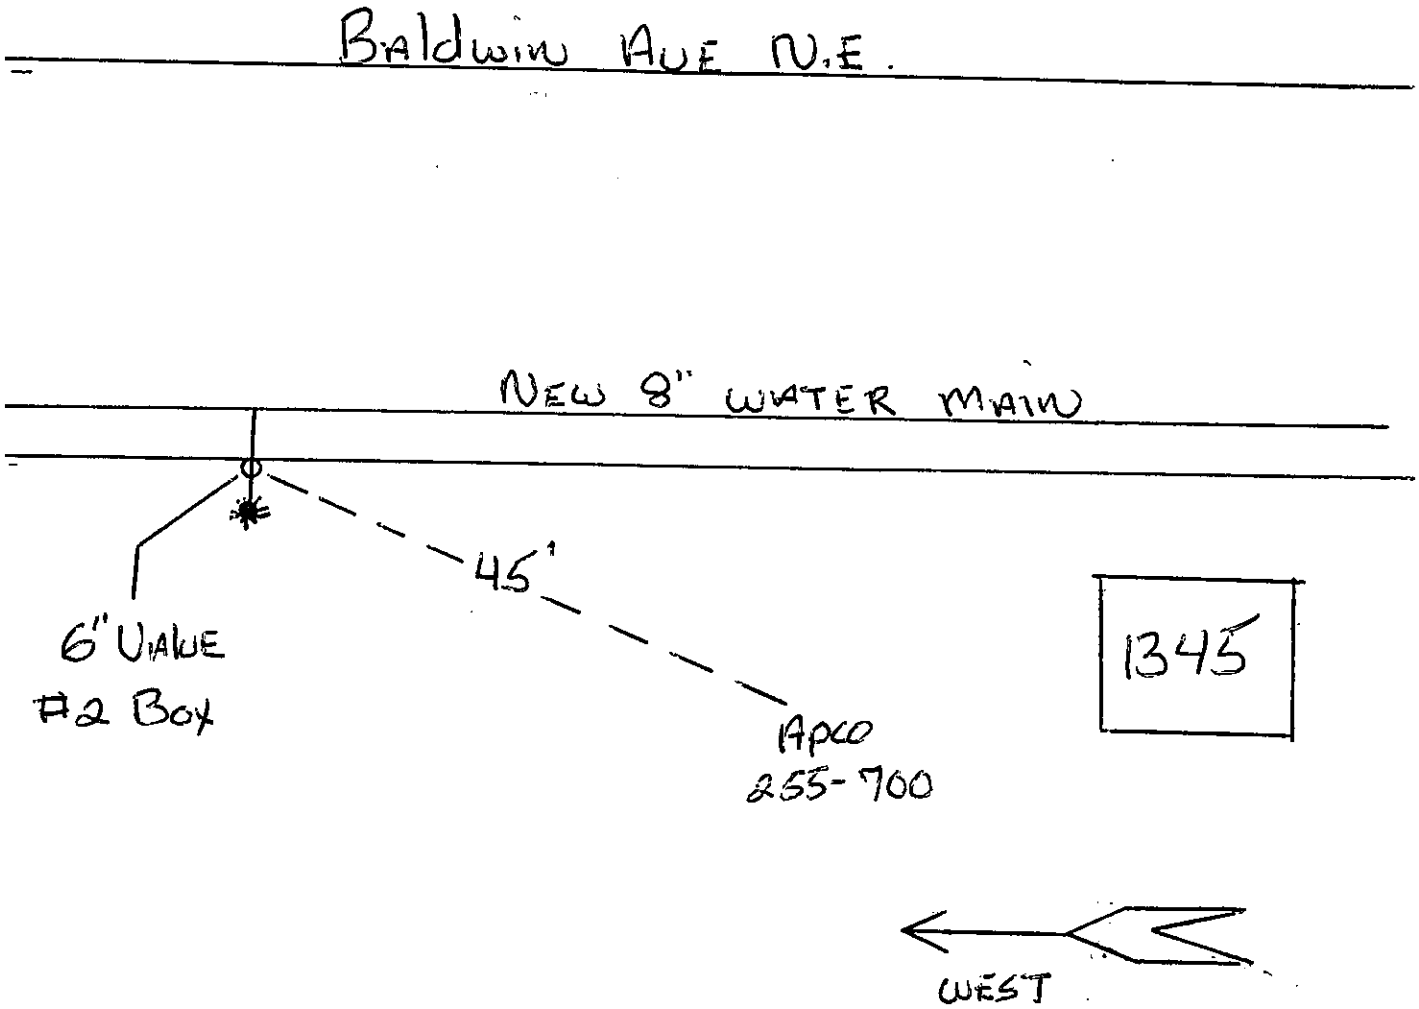

DATE	NO.	SIZE	MAKE	OPEN	TURNS
3-15-04	2	6"	AOK	R.	21

P. L. Measurements

No.	Distance	Direction

CITY OF ROANOKE - WATER DEPT.
VALVE DIAGRAM
1345 Baldwin Ave N.E.

Sec. Map
Date 3-15-04 Page No.