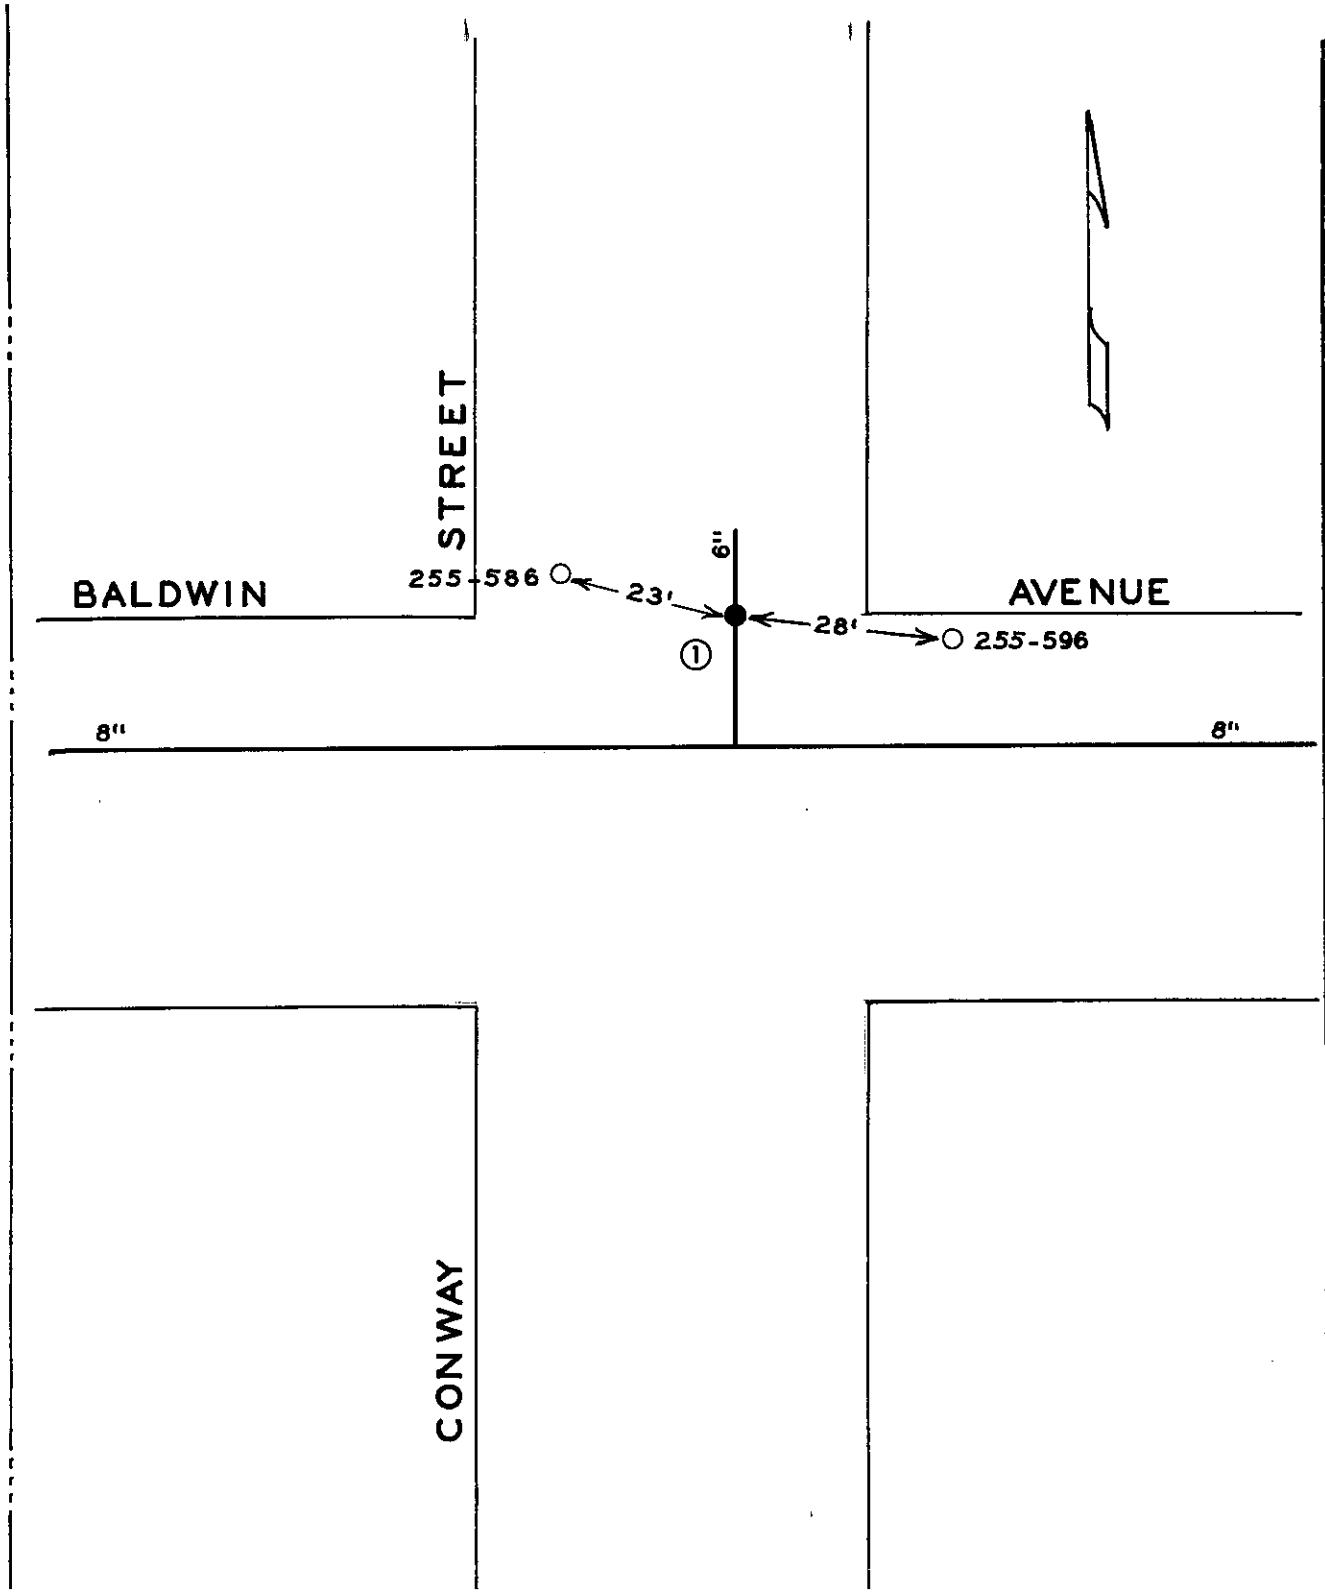

DATE	NO.	SIZE	MAKE	OPEN	TURNS
5-65	1	6"	MUELLER	R	
	1	0	N.P.L.		

CITY OF ROANOKE—WATER DEPT.

VALVE DIAGRAM

BALDWIN AVENUE &

CONWAY STREET N.E.

SEC. MAP 333

DATE PAGE NO.