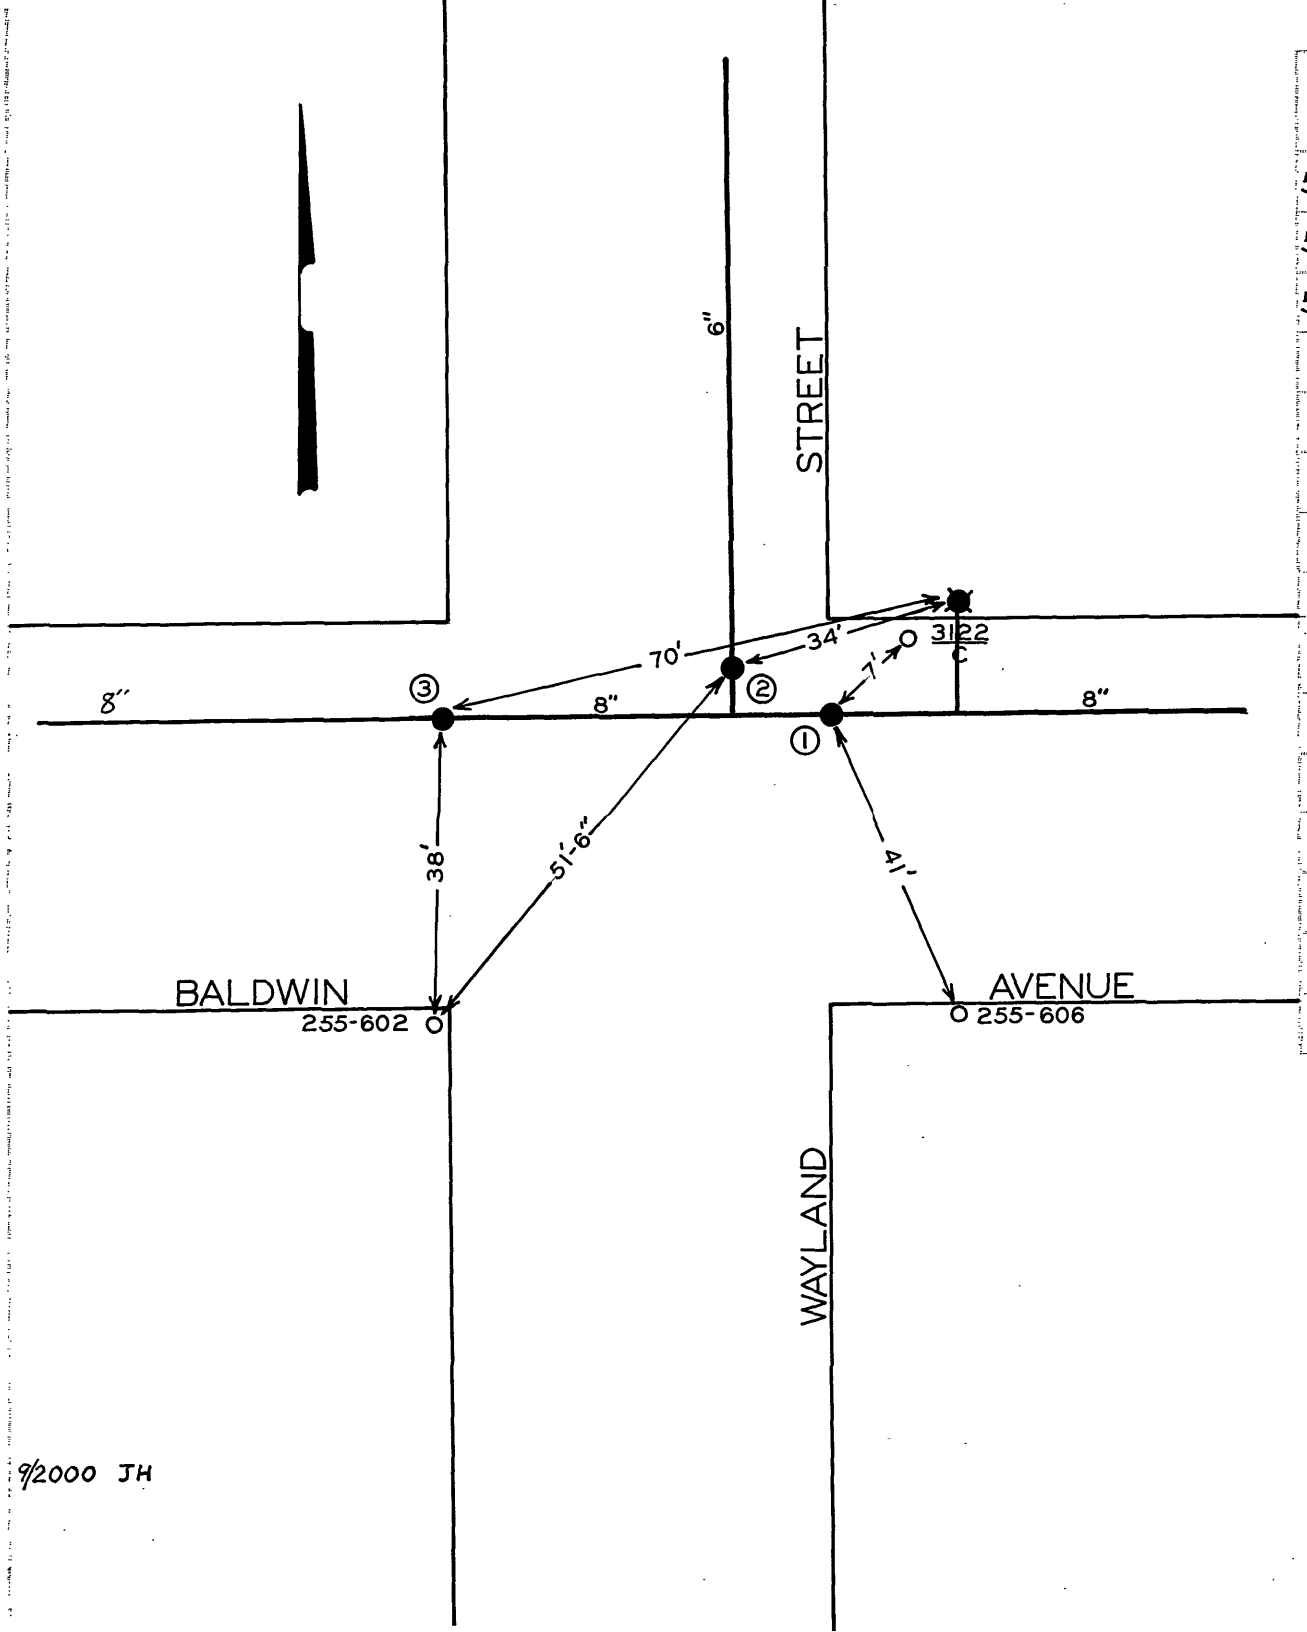

DATE	NO.	SIZE	MAKE	OPEN	TURNS
5-65	1	8"	MUELLER	R	
5-72	2	6"	MUELLER	R	
5-72	3	8"	MUELLER	R	

CITY OF ROANOKE—WATER DEPT.

VALVE DIAGRAM

BALDWIN AVENUE &

WAYLAND STREET

SEC. MAP 333, 321 N.E.

DATE PAGE NO.