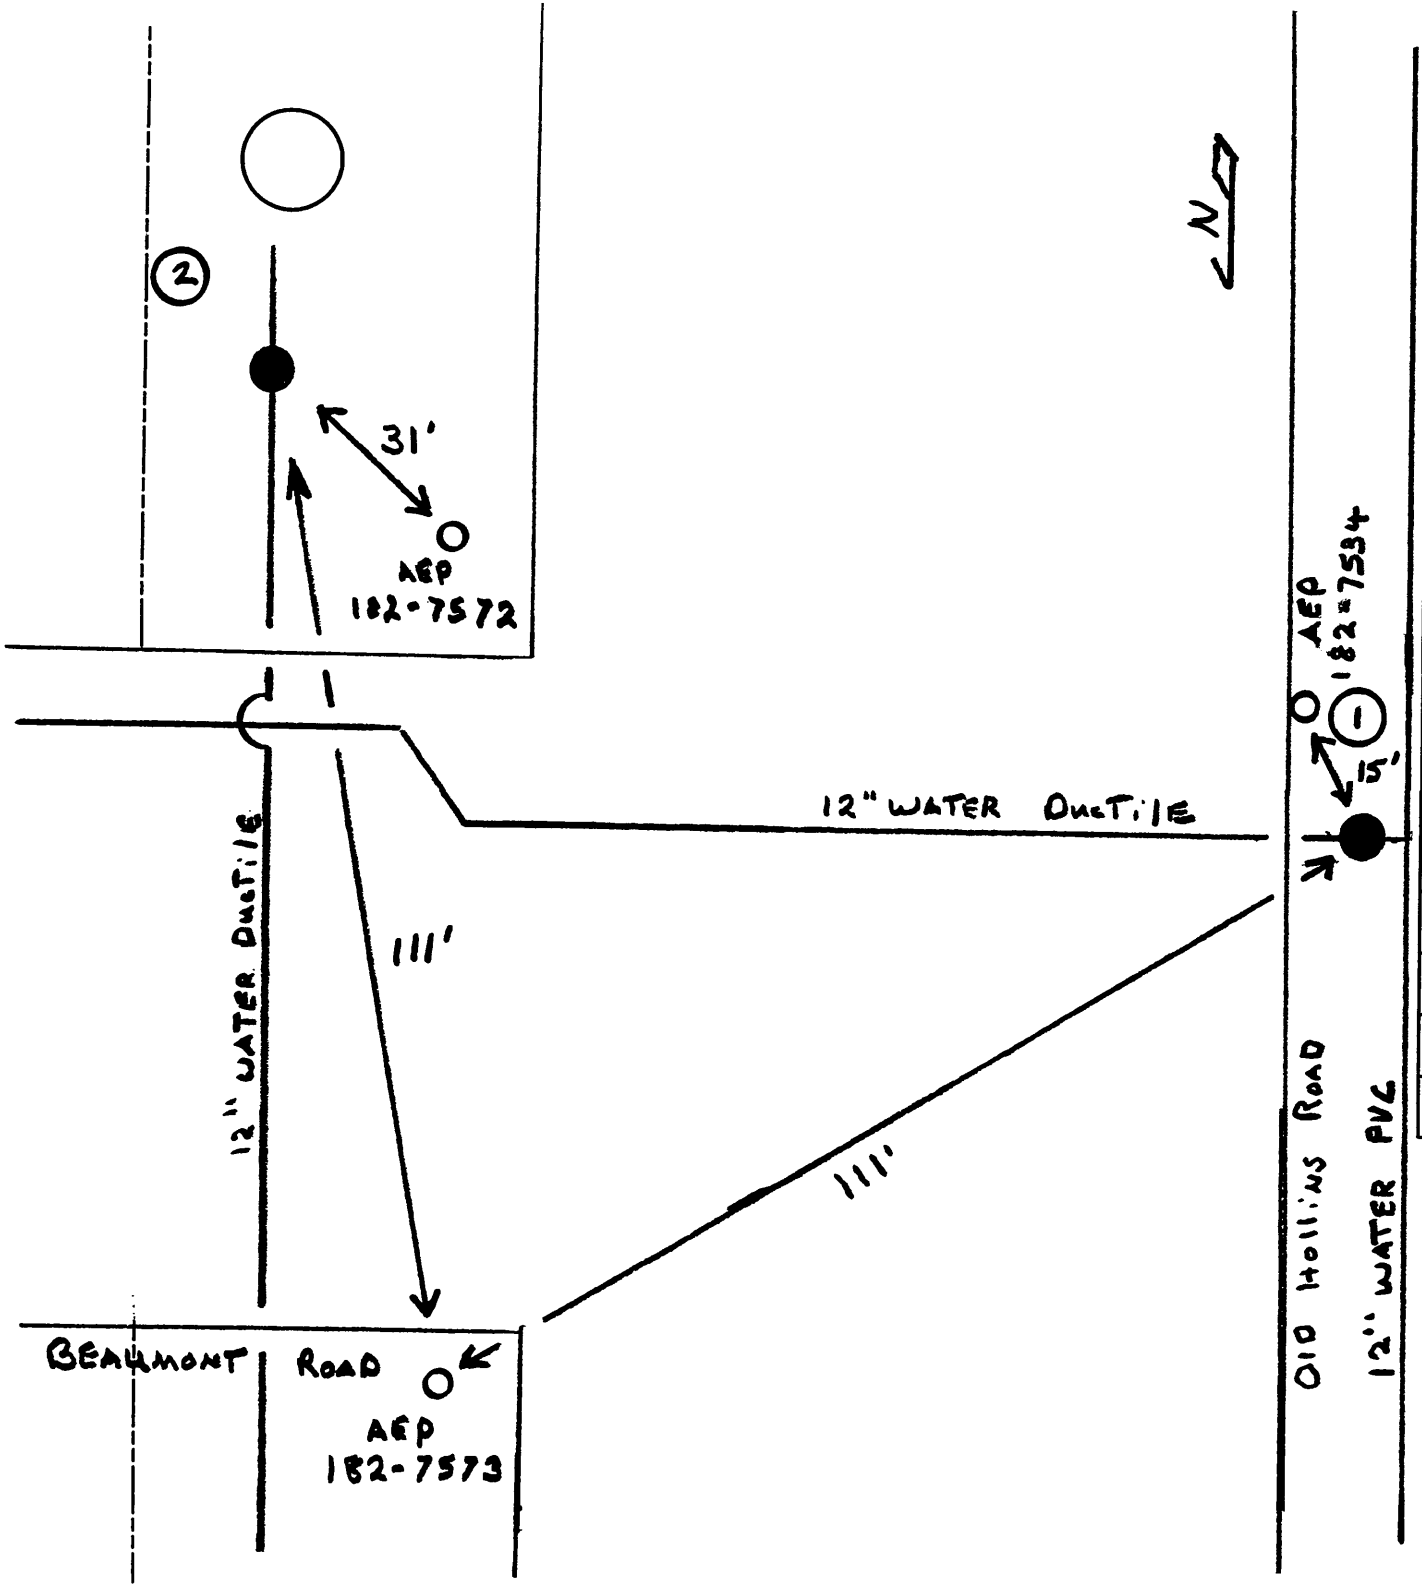


| DATE | NO. | SIZE | MAKE | OPEN | TURNS |
|---|---|---|---|---|---|
| 10/06 | 1 | 12" | MUELLER | R | 39 |
| 4/06 | 2 | 12" | AMERICAN | L | 39 |
| | | | | | |
| | | | | | |
**WESTERN VIRGINIA WATER AUTHORITY**

**VALVE DIAGRAM**

Beaumont Road
OLD HOLLINS ROAD AND
~~BEAMONT ROAD~~

SECT. MAP NE Roanoke Co.

DATE 10-17-06