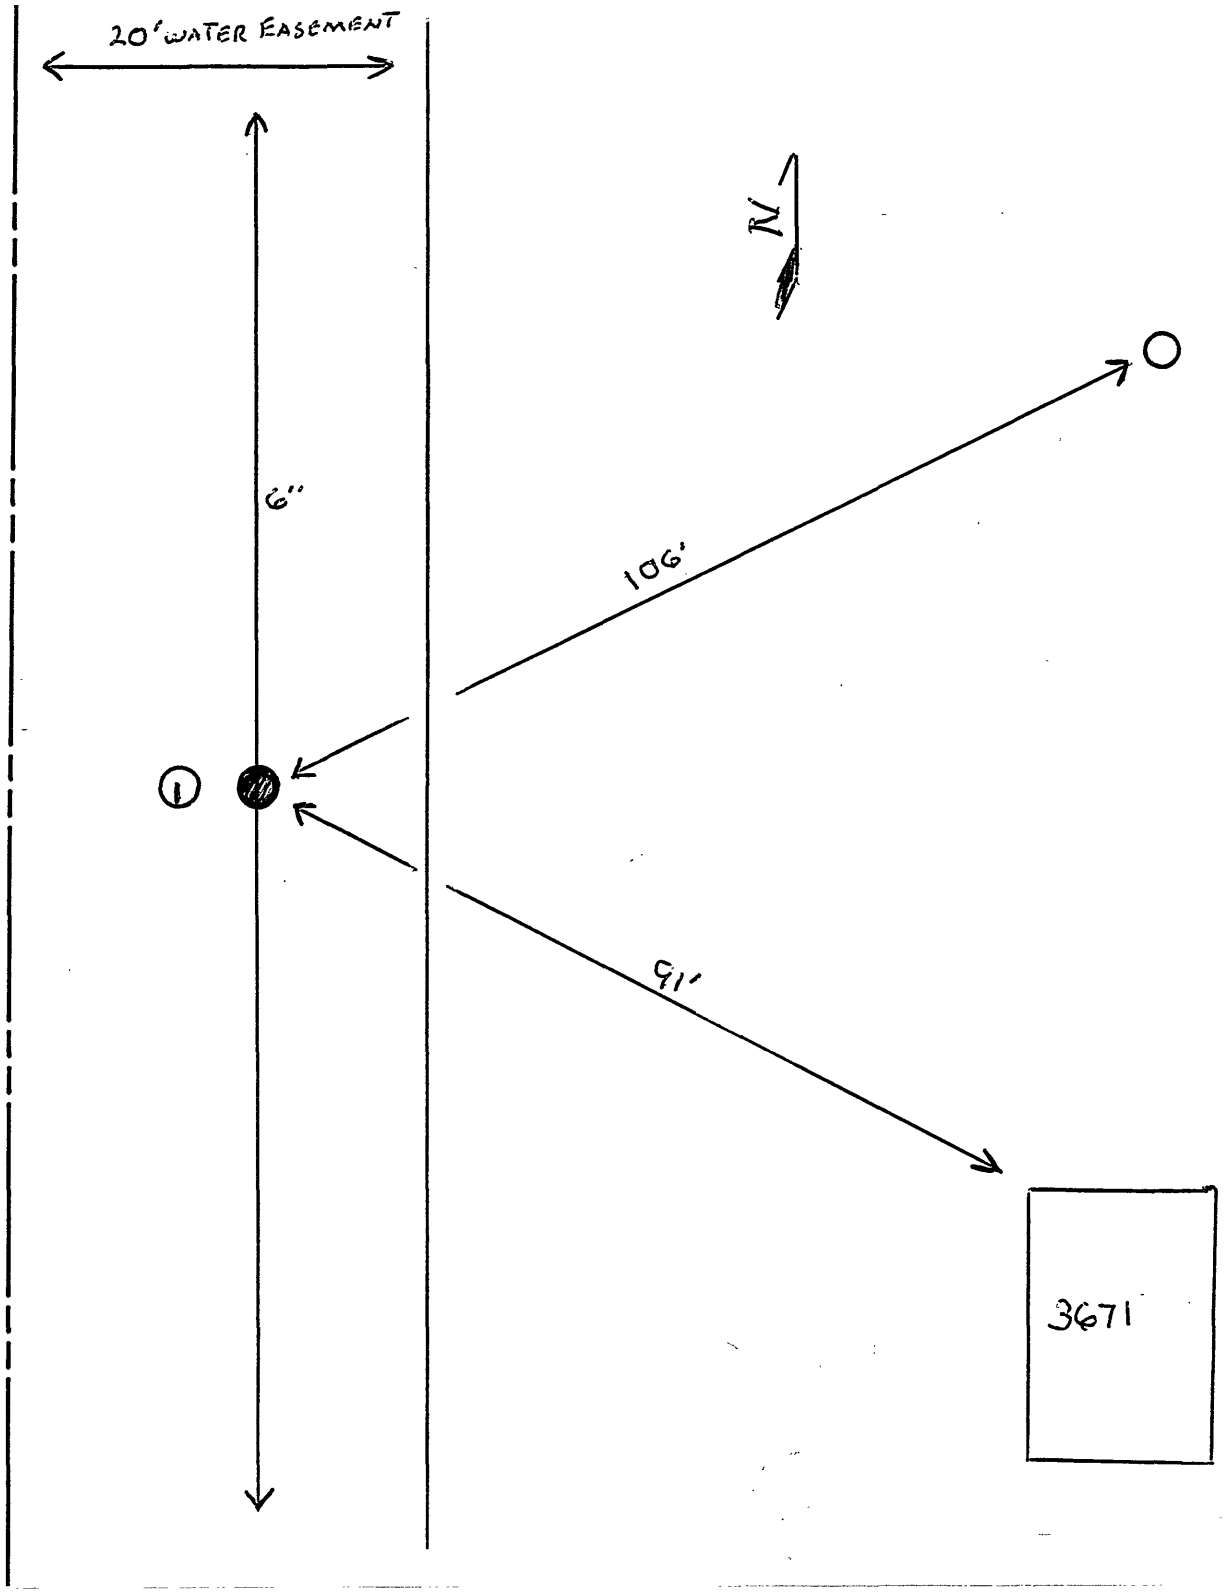

DATE	NO.	SIZE	MAKE	OPEN	TURNS
99	1		AIR RELEASE		

WUWA WATER DEP'T.

VALVE DIAGRAM

BEHIND 3671 BELLE AVE NE

Belle Ave - 3671 - Behind House. NE

SEC. MAP

DATE: 8-12-04 PAGE NO.