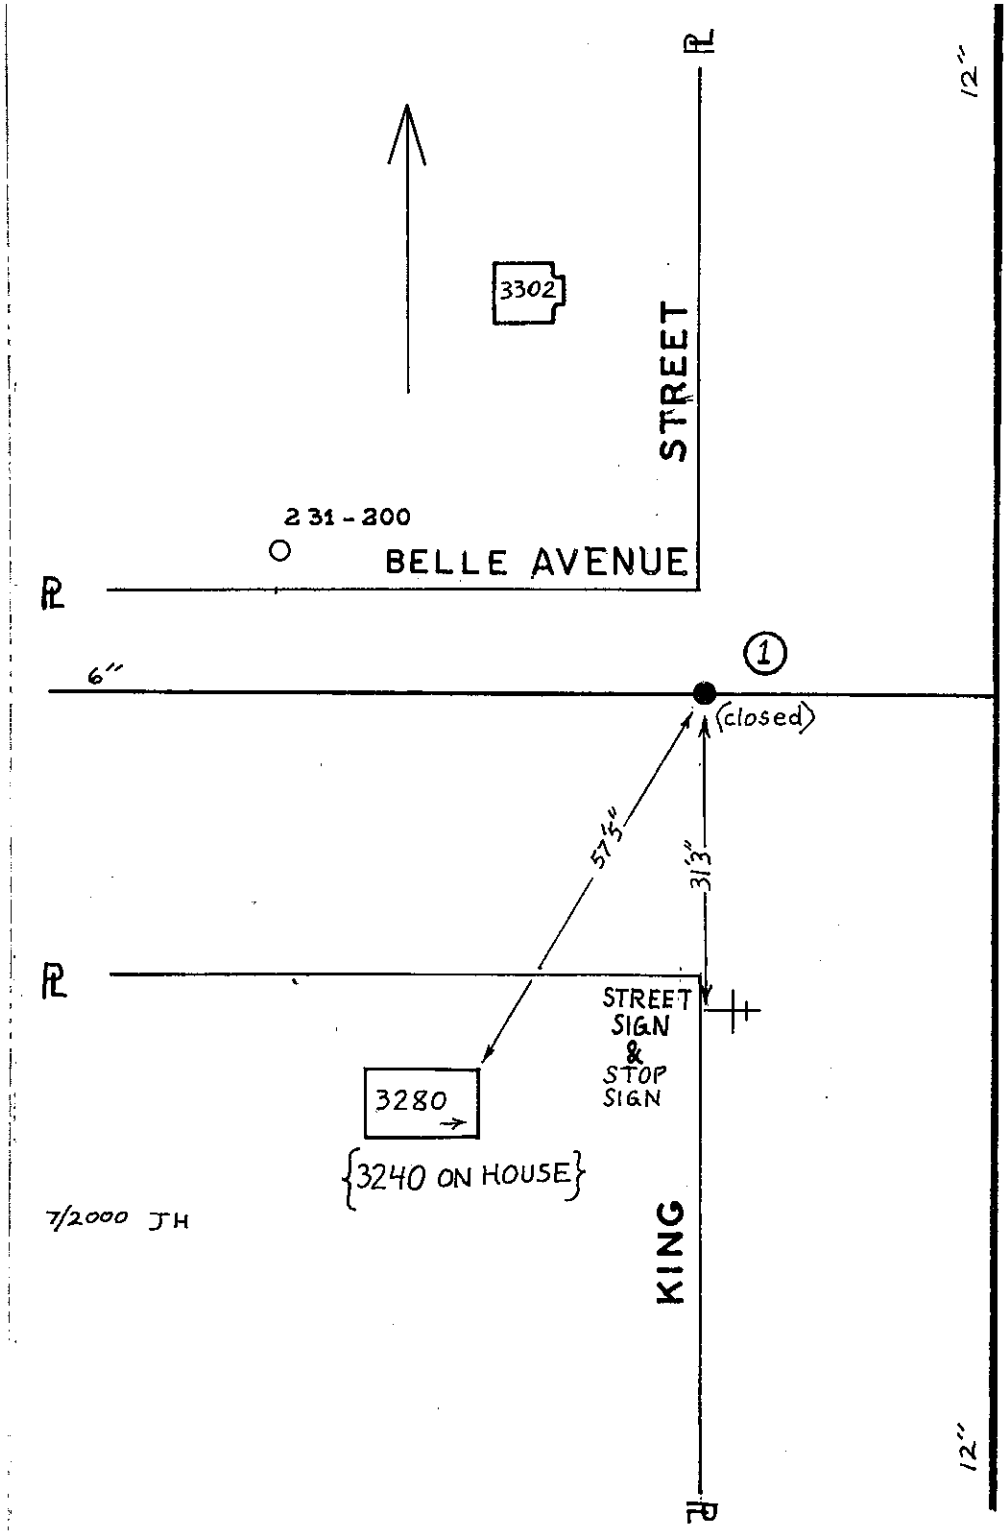

DATE	NO.	SIZE	MARK	OPEN	TERMS
1978	1	6"			

BELLE

(RT. 758)

AVENUE

Belle Ave
~~HARWOOD DRIVE~~ 150'
WEST OF KING STREET N.E.

708, 705