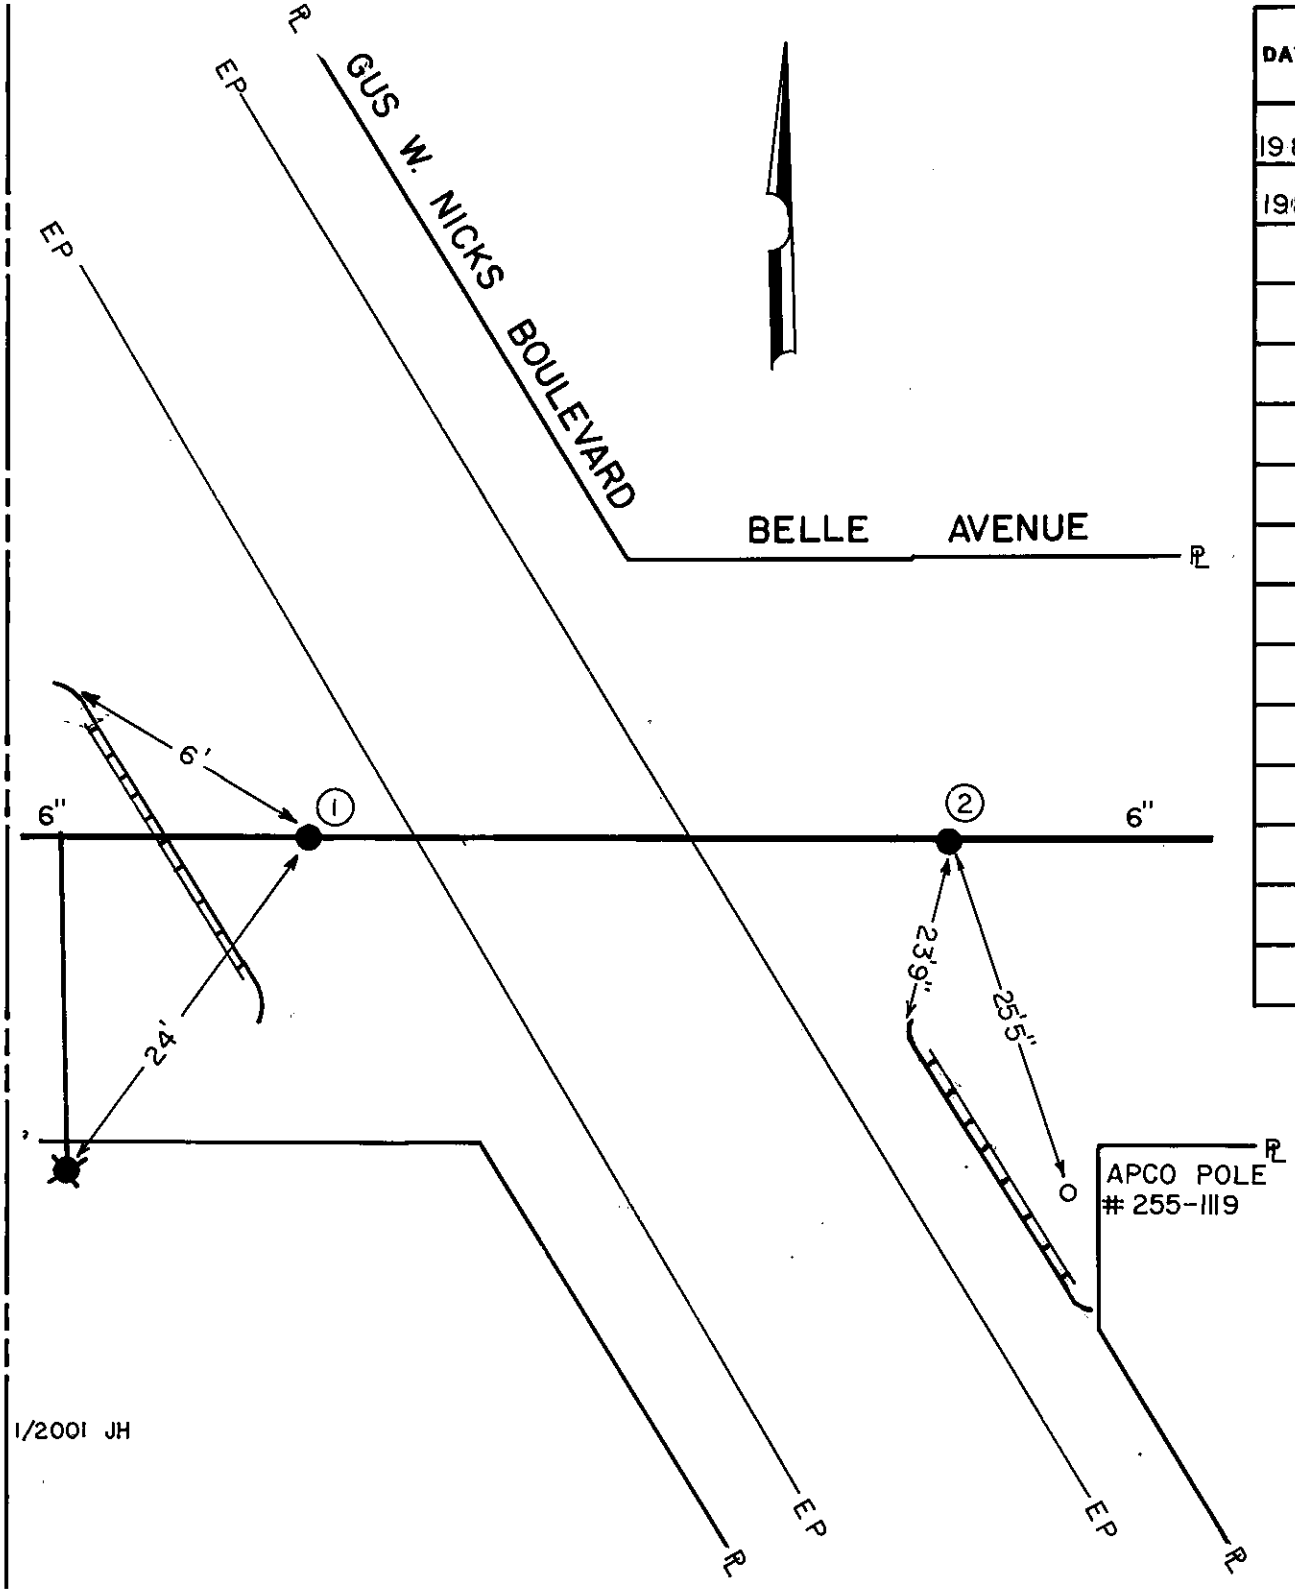

DATE	NO.	SIZE	MAKE	OPEN	TURNS
1981	1	6"			
1981	2	6"			

CITY OF ROANOKE - WATER DEP'T.

VALVE DIAGRAM

BELLE AVENUE &

GUS W. NICKS BLVD.

SEC. MAP 332, 341 N.W.

DATE: PAGE NO.