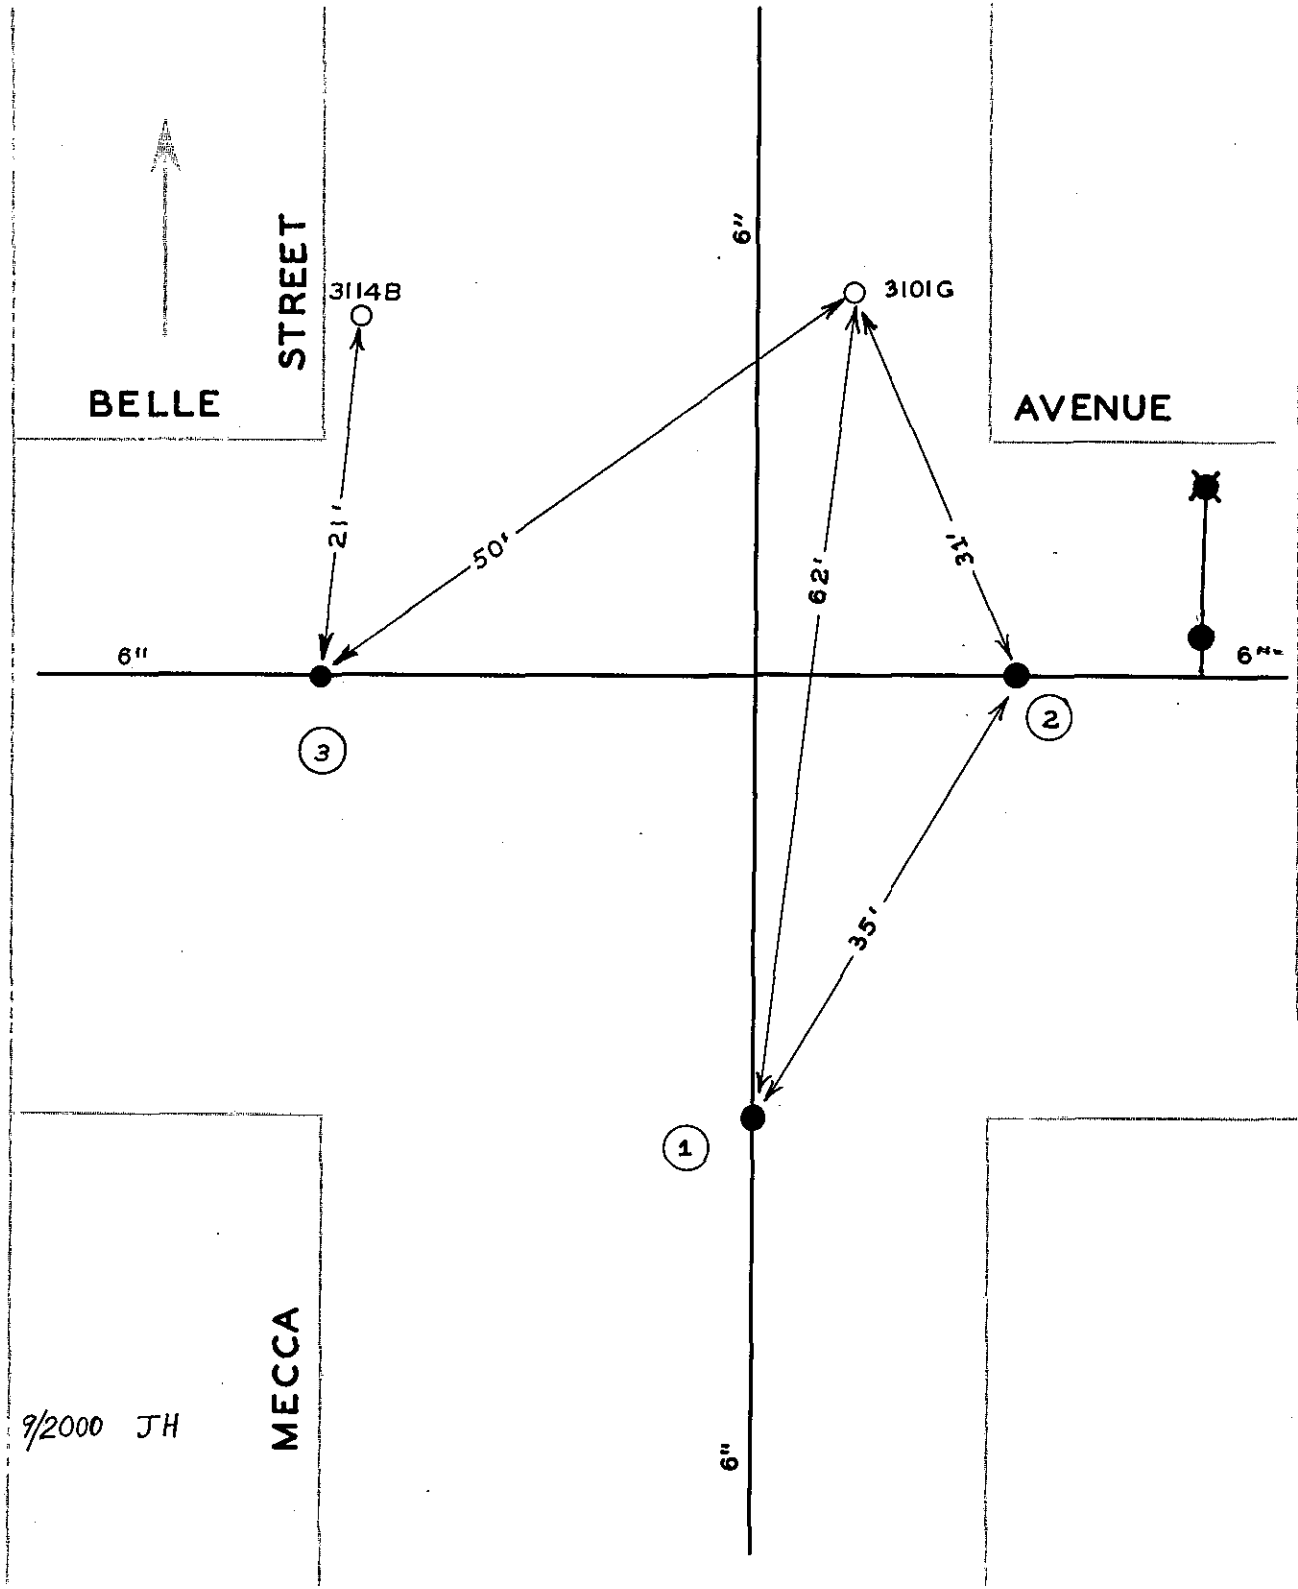

DATE	NO.	SIZE	MAKE	OPEN	TURNS
7-60	1	6"	MUELLER	R	
7-60	2	6"	MUELLER	R	
8-63	3	6"	MUELLER	R	
	1	0	S.P.L.		
	2	2' E.	E.P.L.		
	3	0	W.P.L.		

CITY OF ROANOKE—WATER DEPT

VALVE DIAGRAM

BELLE AVENUE &

MECCA STREET

SEC. MAP 341 N.E.

DATE PAGE NO.