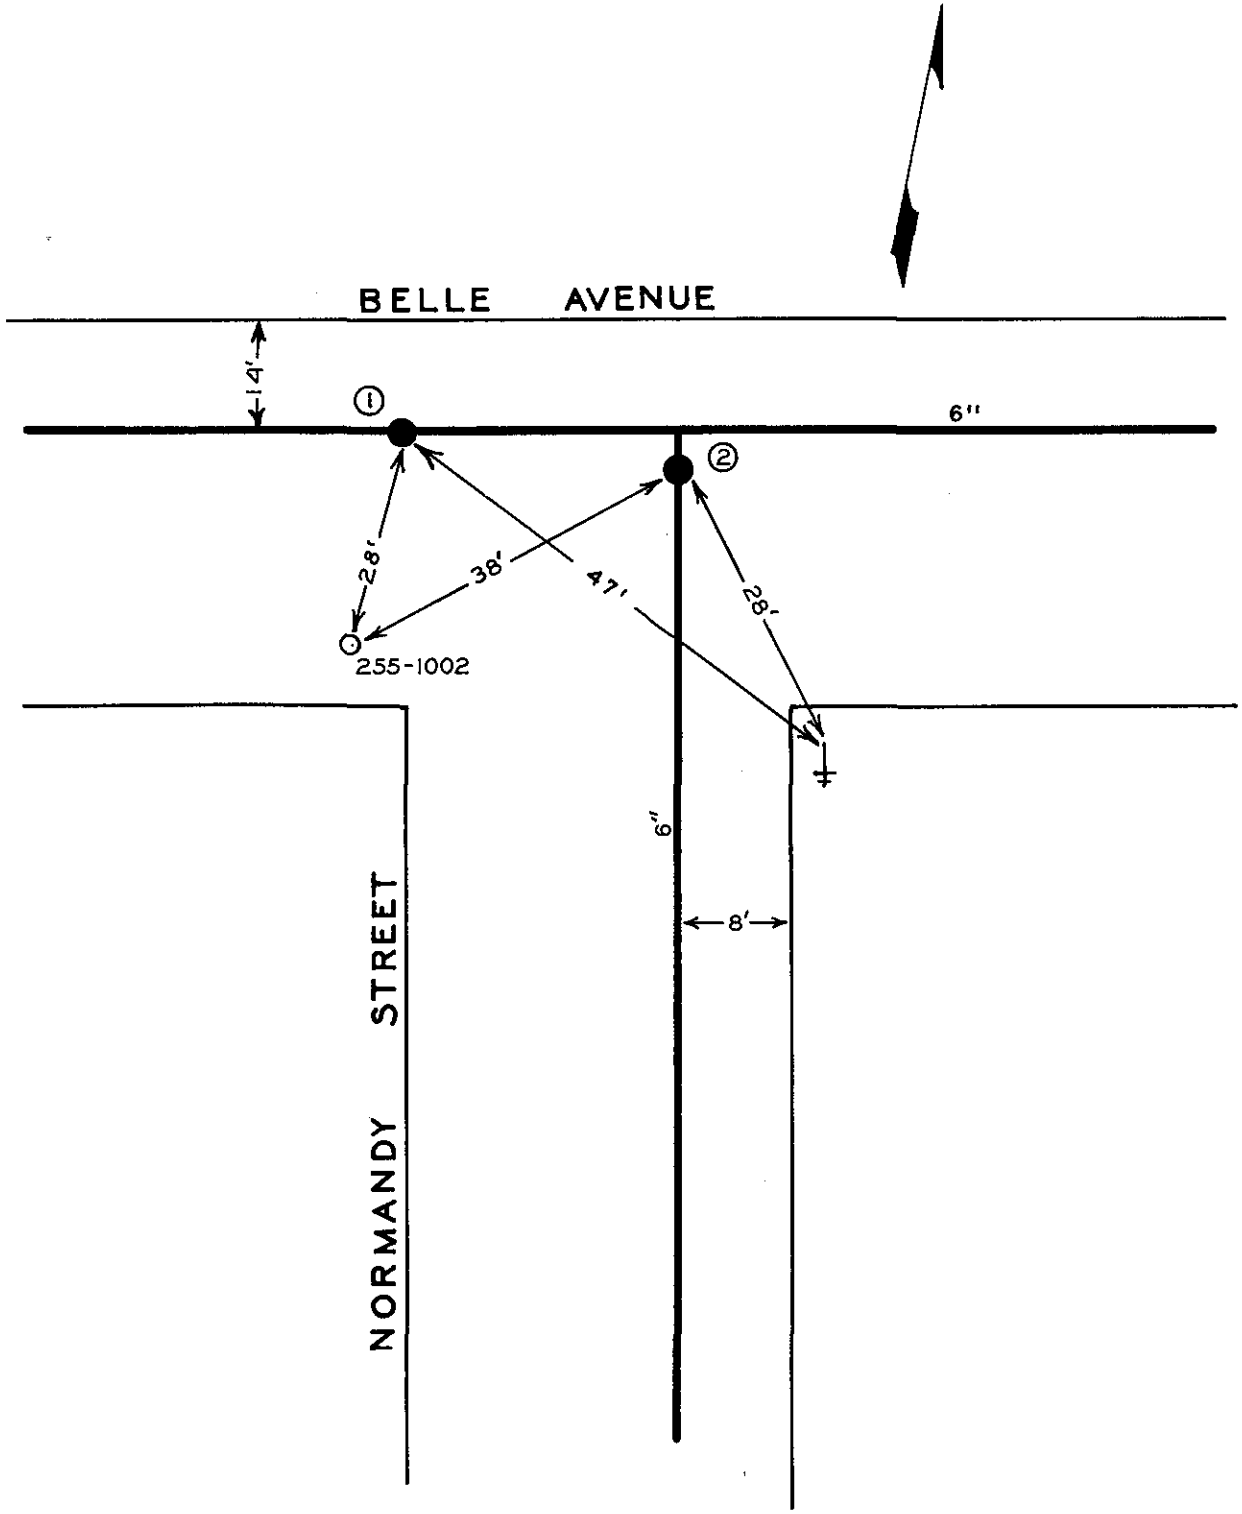

DATE	NO.	SIZE	MAKE	OPEN	TURNS
7-67	1	6"	MUELLER	R	21
71	2	6"	DARLING	R	
	1	0	W.P.L.		
	2	27'-N	S.P.L.		

CITY OF ROANOKE—WATER DEPT.

VALVE DIAGRAM

BELLE AVENUE &

NORMANDY STREET N.E.

SEC. MAP 332 - 41

DATE **PAGE NO.**