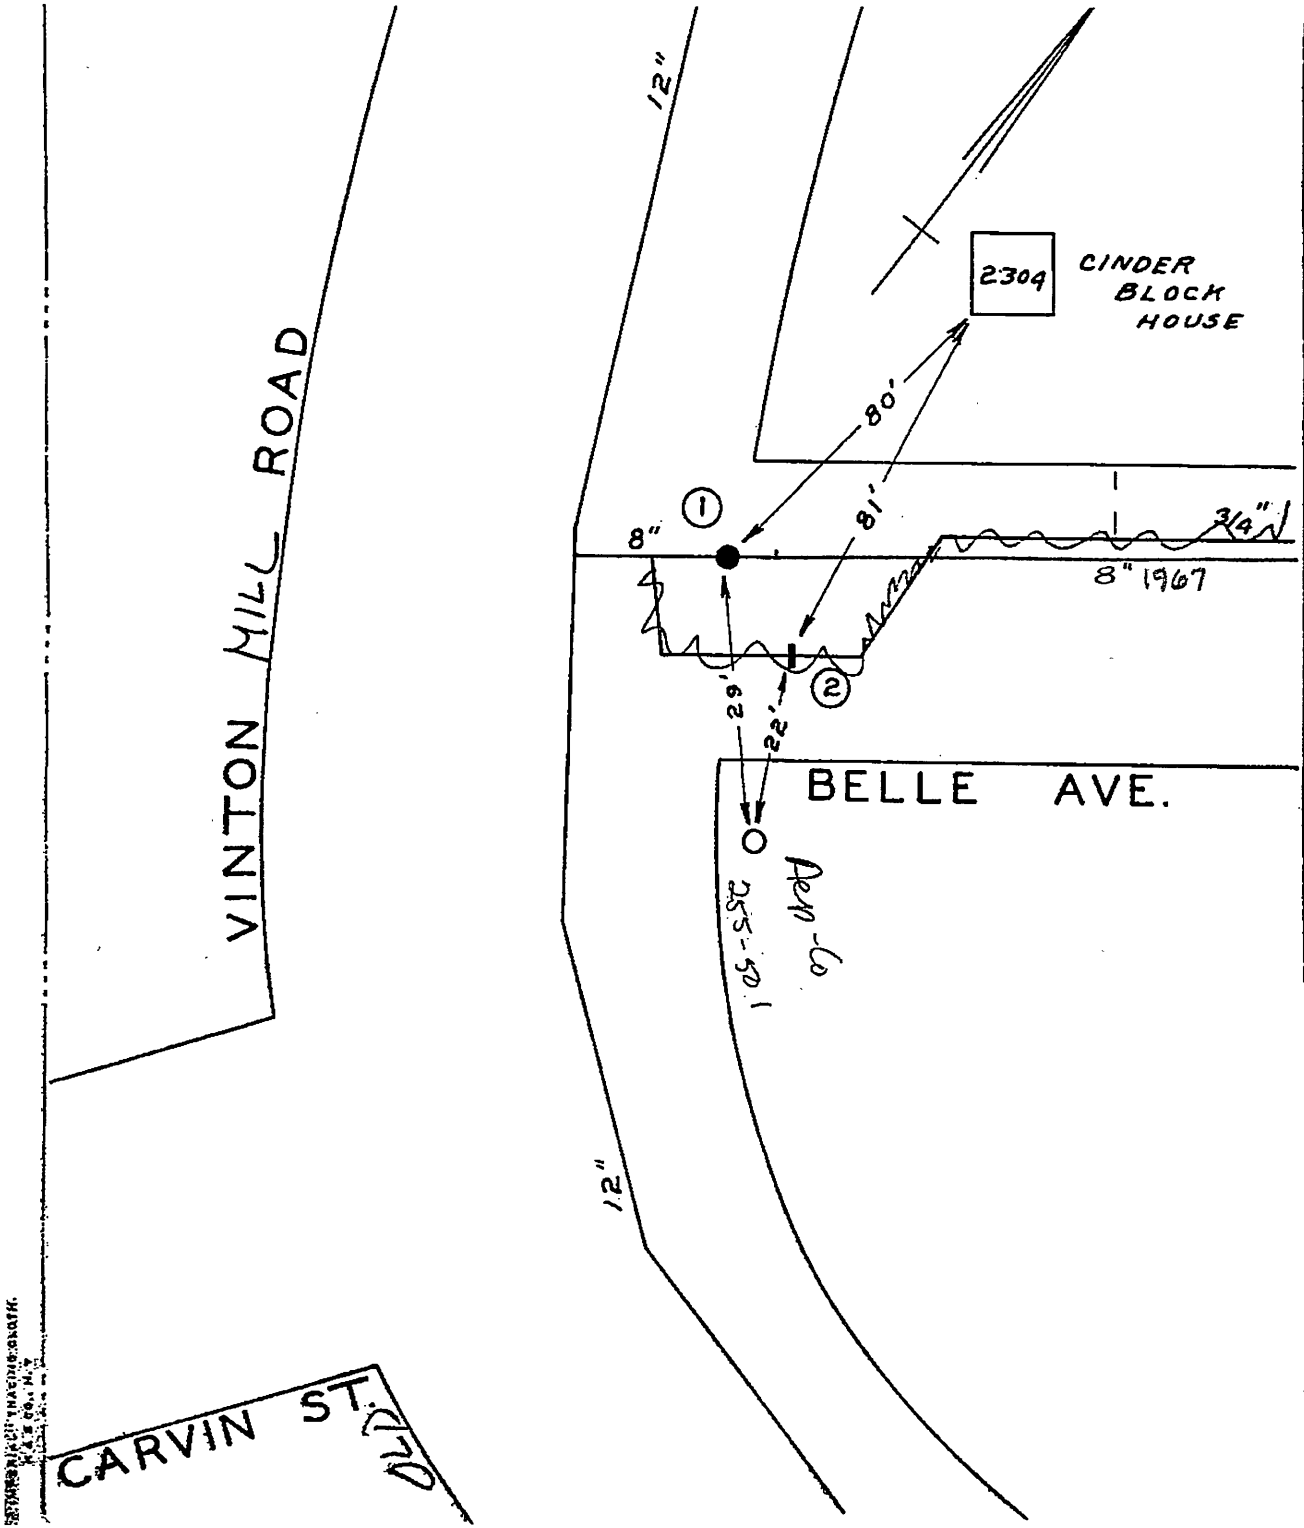

DATE	NO.	SIZE	MAKE	OPEN	TURNS
1952	1	8"			
	~~2~~	~~3/4"~~	~~CURBCOCK~~		
	1	26'-W	EPL		
	~~2~~	~~19'6"W~~	~~EPL~~		

Name Change from Vinton Mill Rd to Old Vinton Mill Rd. when Gus W. Nicks Blvd was constructed east of here.

CITY OF ROANOKE—WATER DEPT.

VALVE DIAGRAM

BELLE AVENUE &

VINTON ~~Mill RD.~~ N. E.

Old Vinton Mill Rd.

SEC. MAP 332

DATE PAGE NO.