DATE	NO.	SIZE	MAKE	OPEN	TURNS
99	1	6	AMERICAN	R	21

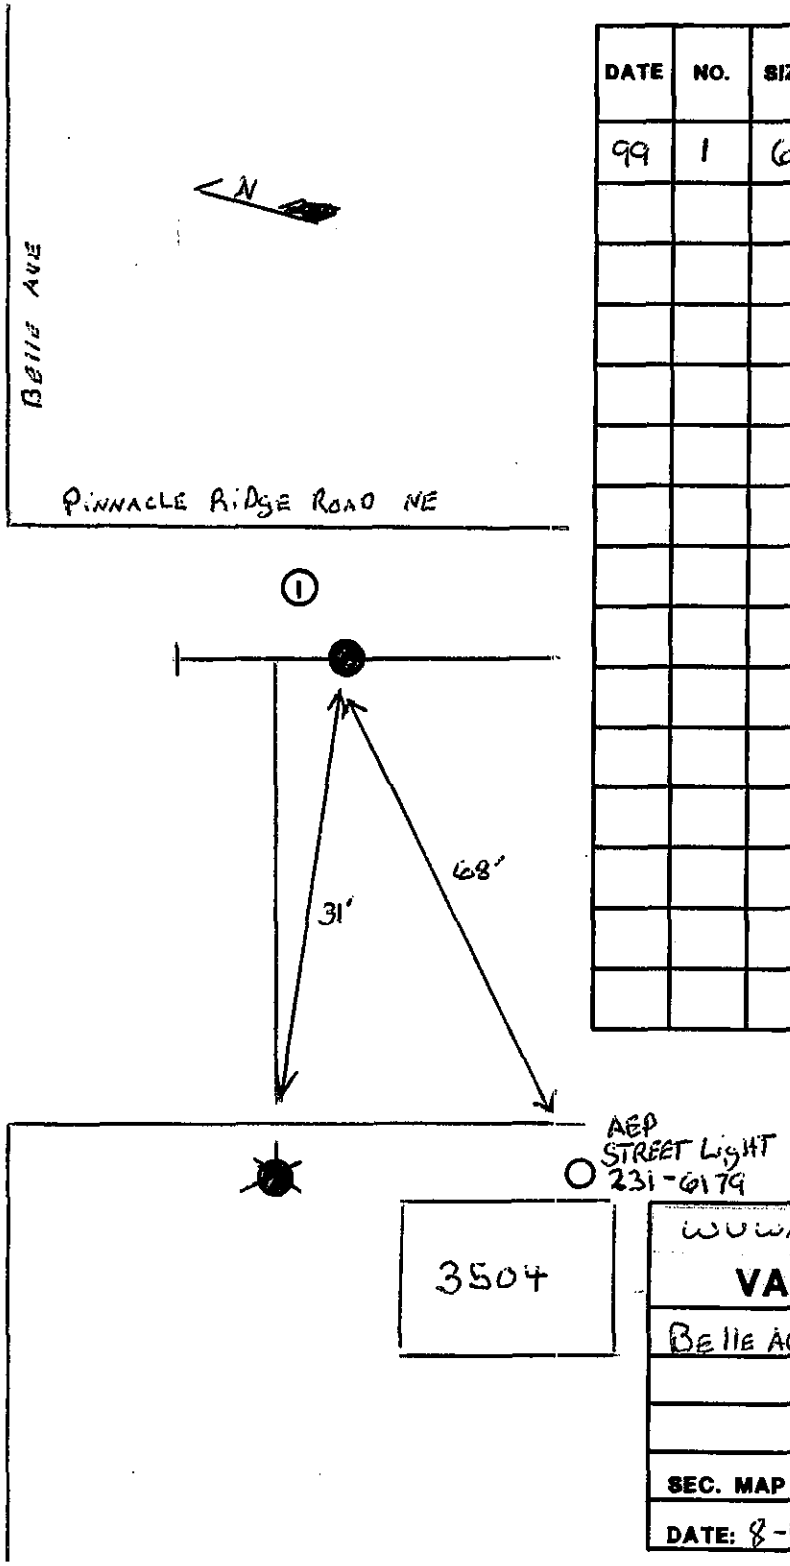

WUWA WATER DEP'T.

VALVE DIAGRAM

BELLE AVE AND PINNACLE RIDGE NE

SEC. MAP

DATE: 8-12-04 PAGE NO.