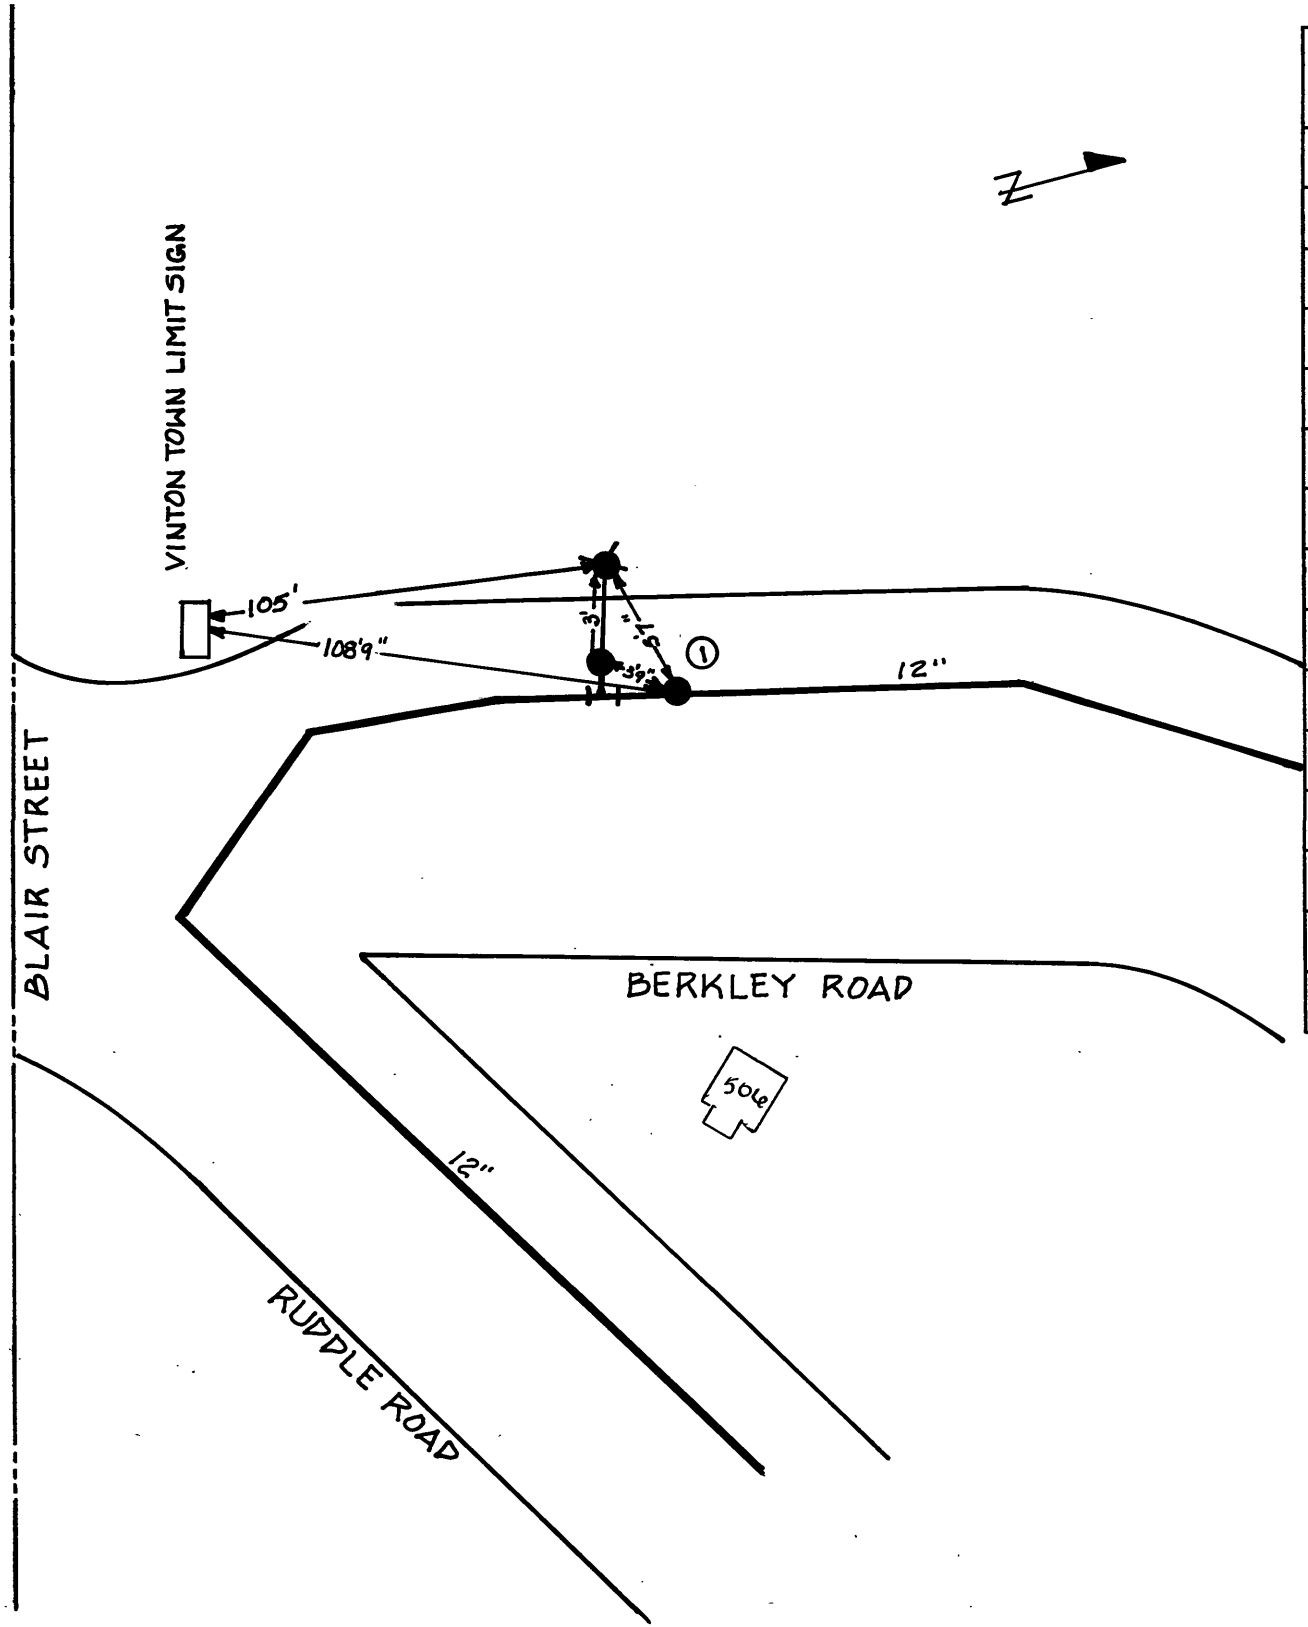

DATE	NO.	SIZE	MAKE	OPEN	TURNS
11-80	1	12"	MUELLER	R	

CITY OF ROANOKE—WATER DEP'T

VALVE DIAGRAM

BERKLEY ROAD (VINTON)

BLAIR STREET (VINTON)

RUDDLE ROAD (VINTON) N.E.

SEC. MAP 701

DATE NOV. 28, 1980 PAGE NO.