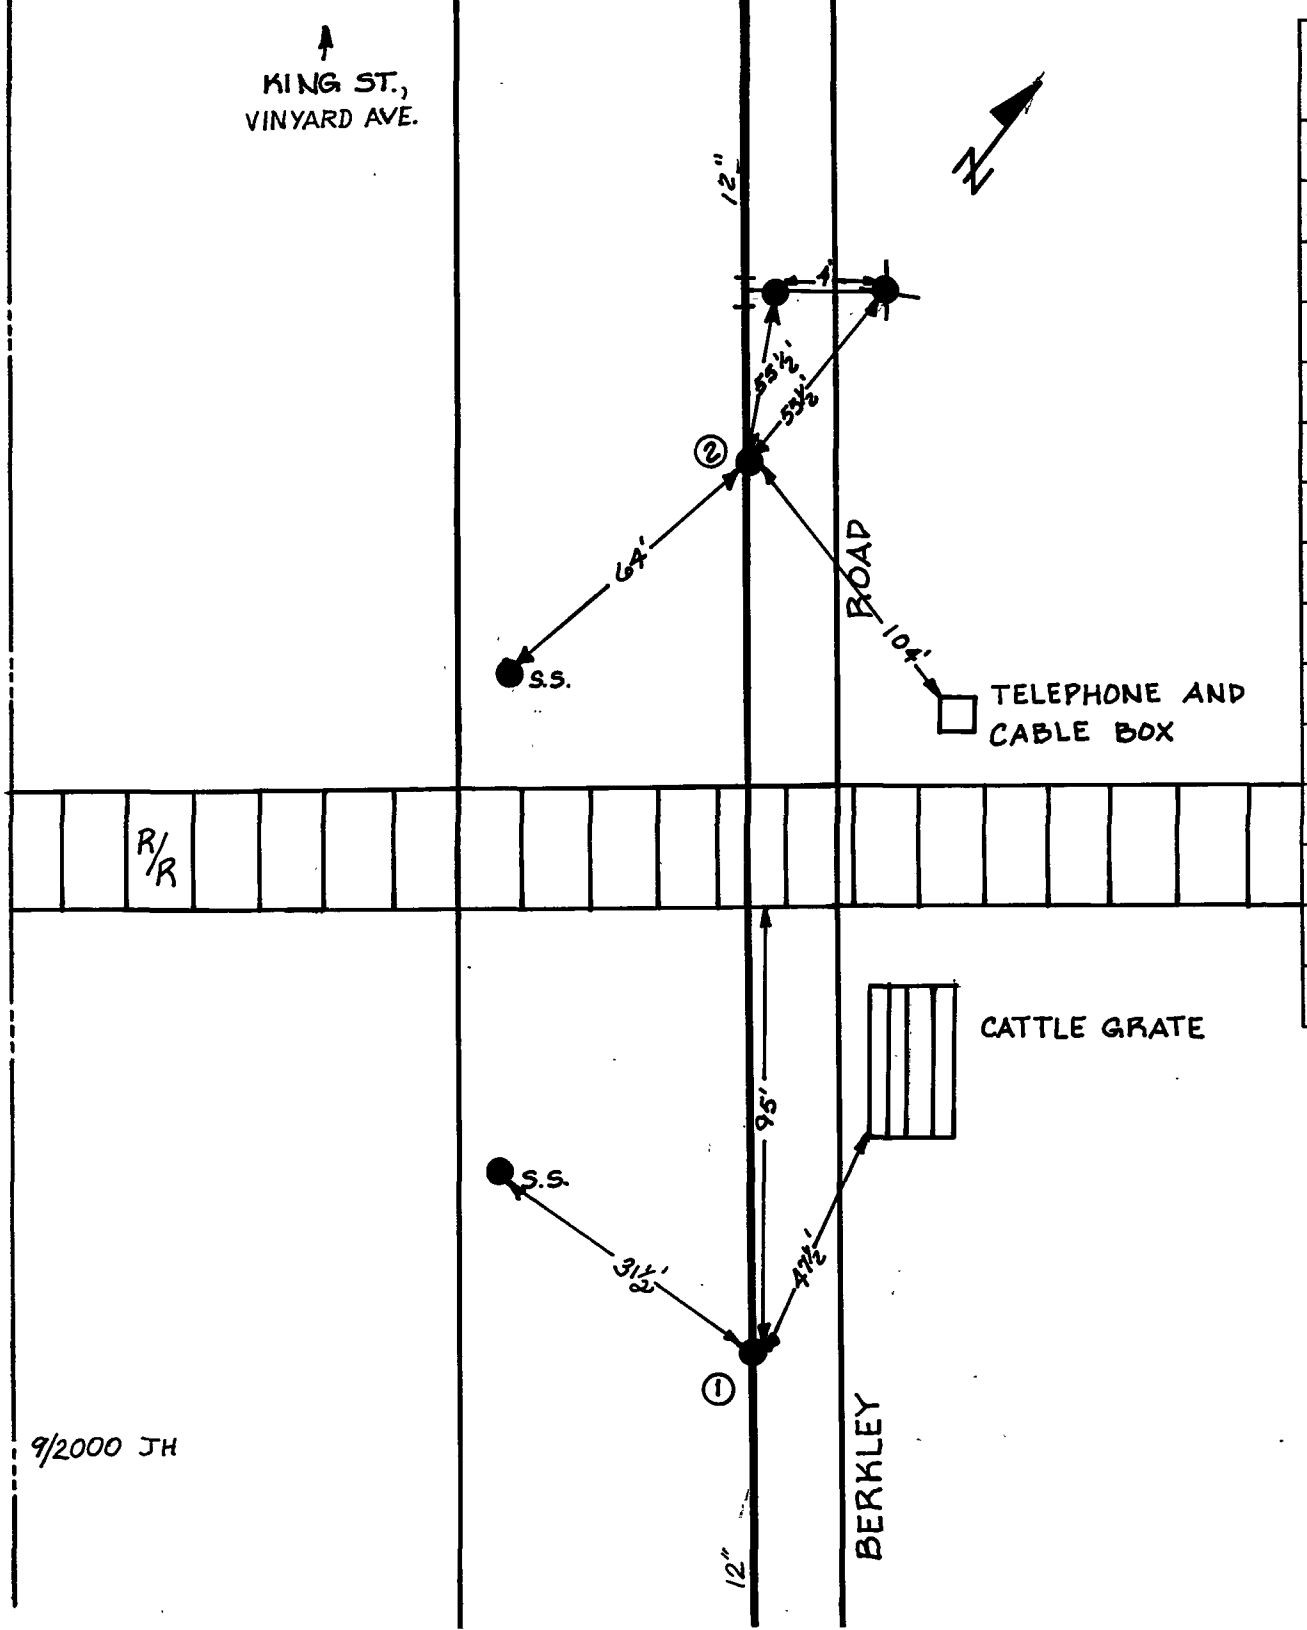

DATE	NO.	SIZE	MAKE	OPEN	TURNS
11-80	1	12"	MUELLER	R	
11-80	2	12"	MUELLER	R	

9/2000 JH

CITY OF ROANOKE—WATER DEP'T
VALVE DIAGRAM
BERKLEY ROAD-Railroad Tracks
SOUTH OF VINYARD AVE.
SEC. MAP 705, 702, 704 N.E.
DATE NOV. 28, 1980 PAGE NO.