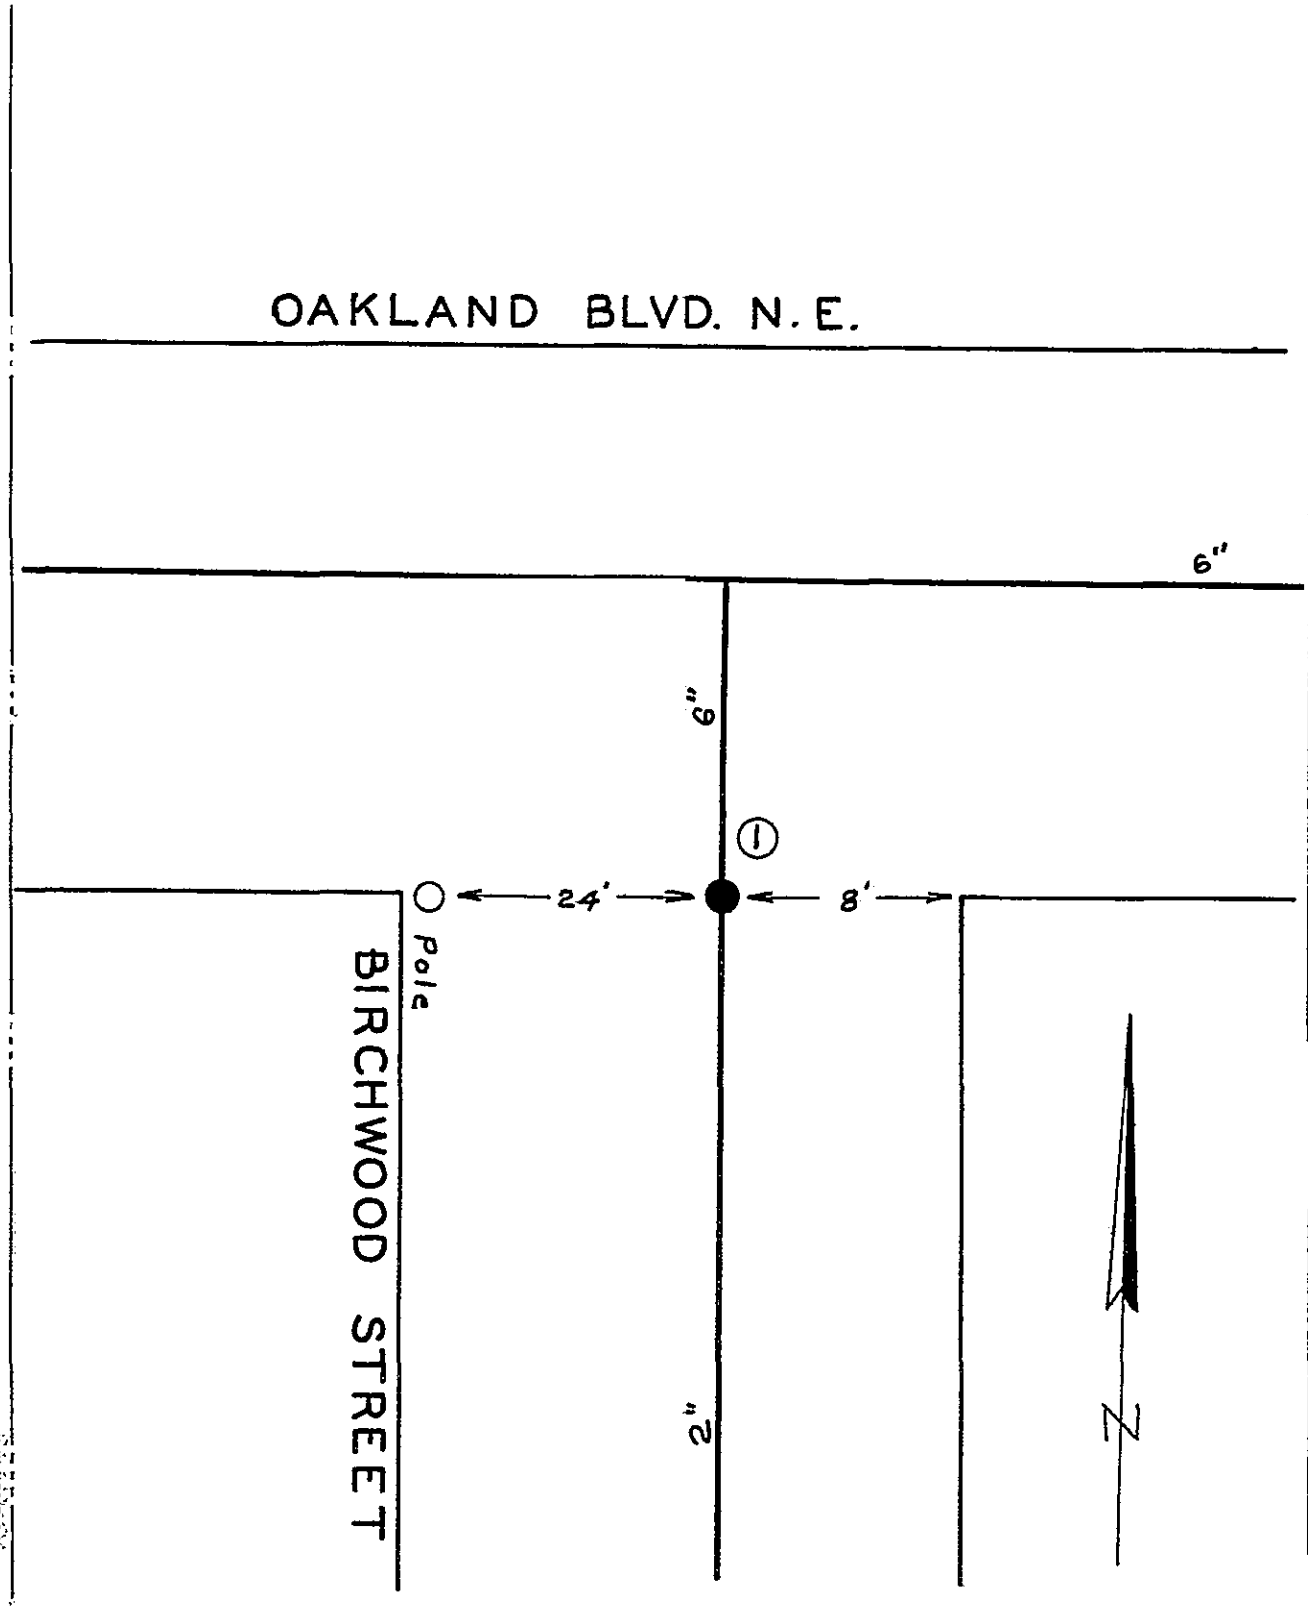

DATE	NO.	SIZE	MAKE	OPEN	TURNS
12-55	1	2"	DARLING	R	7
	1	0	SPL		

CITY OF ROANOKE—WATER DEPT.

VALVE DIAGRAM

BIRCHWOOD ST. & OAKLAND BLVD. N.E. OR N.W.

SEC. MAP 209-317

DATE PAGE NO.

IMPERIAL TRACING CLOTH