DATE	NO.	SIZE	MAKE	OPEN	TURNS
~~1991~~	~~1~~	~~2"~~	~~BLOW OFF~~	~~L~~	~~—~~
1994	1	16"	BYPASS		

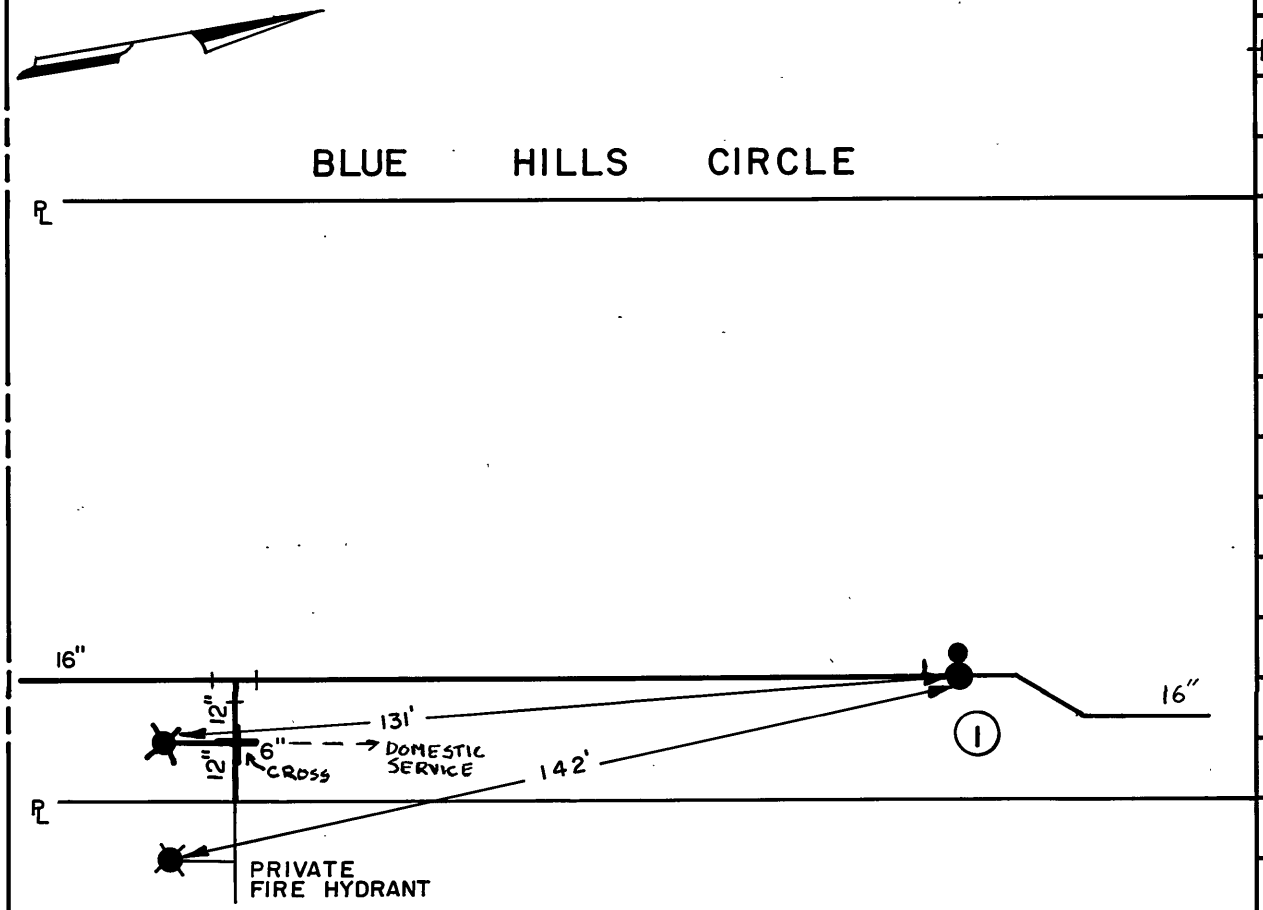

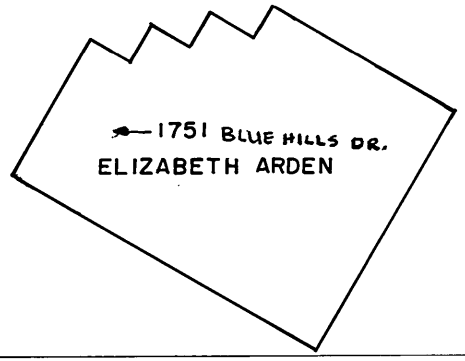

CITY OF ROANOKE - WATER DEP'T.

VALVE DIAGRAM

BLUE HILLS CIRCLE

NORTH OF 1751 BLUE HILLS DRIVE

SEC. MAP 721, 728 N.E.

DATE: PAGE NO.

12/91 NP
3/2001 NP