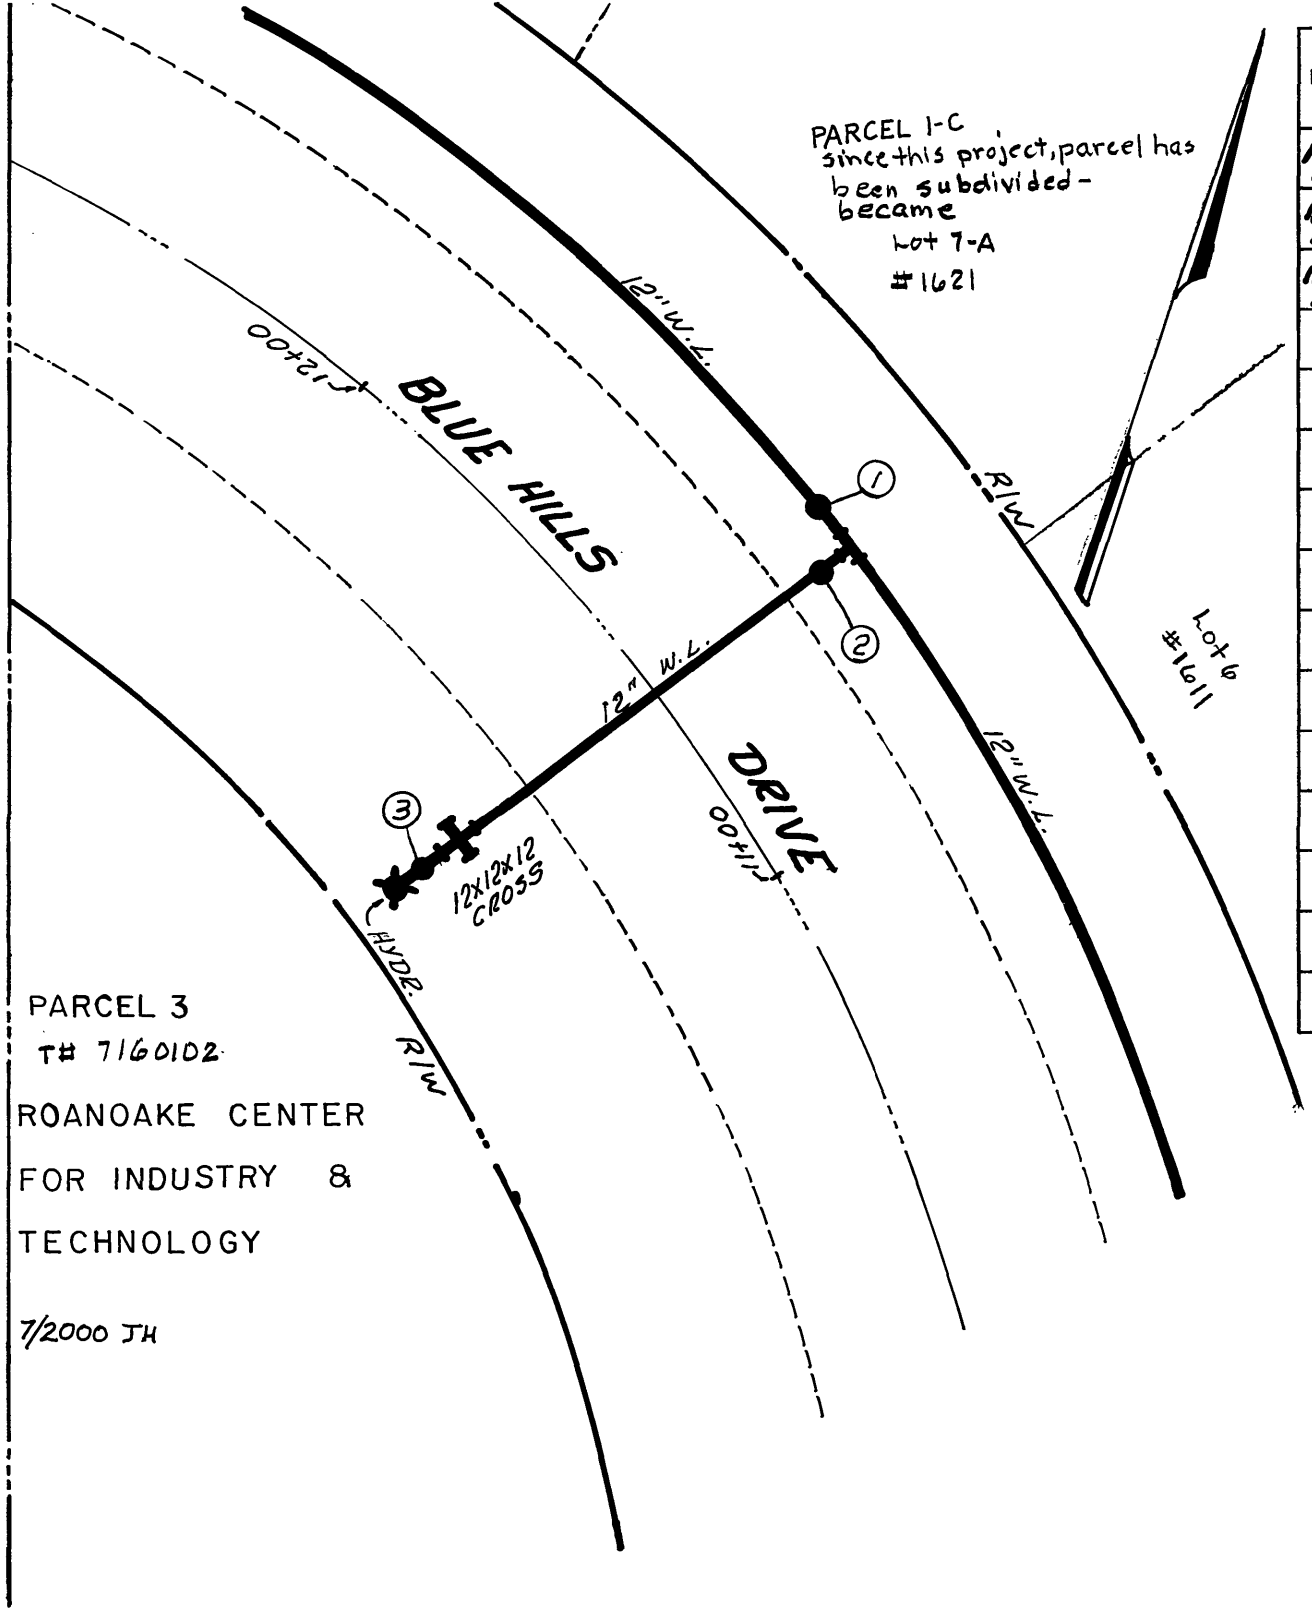

DATE	NO.	SIZE	MAKE	OPEN	TURNS
12/64	1	12"			
12/64	2	12"			
12/64	3	6"			

CITY OF ROANOKE—WATER DEP'T
VALVE DIAGRAM

BLUE HILLS DRIVE, N.E.

1600 BLK

SEC. MAP 716, 721

DATE 4-10-85 PAGE NO.