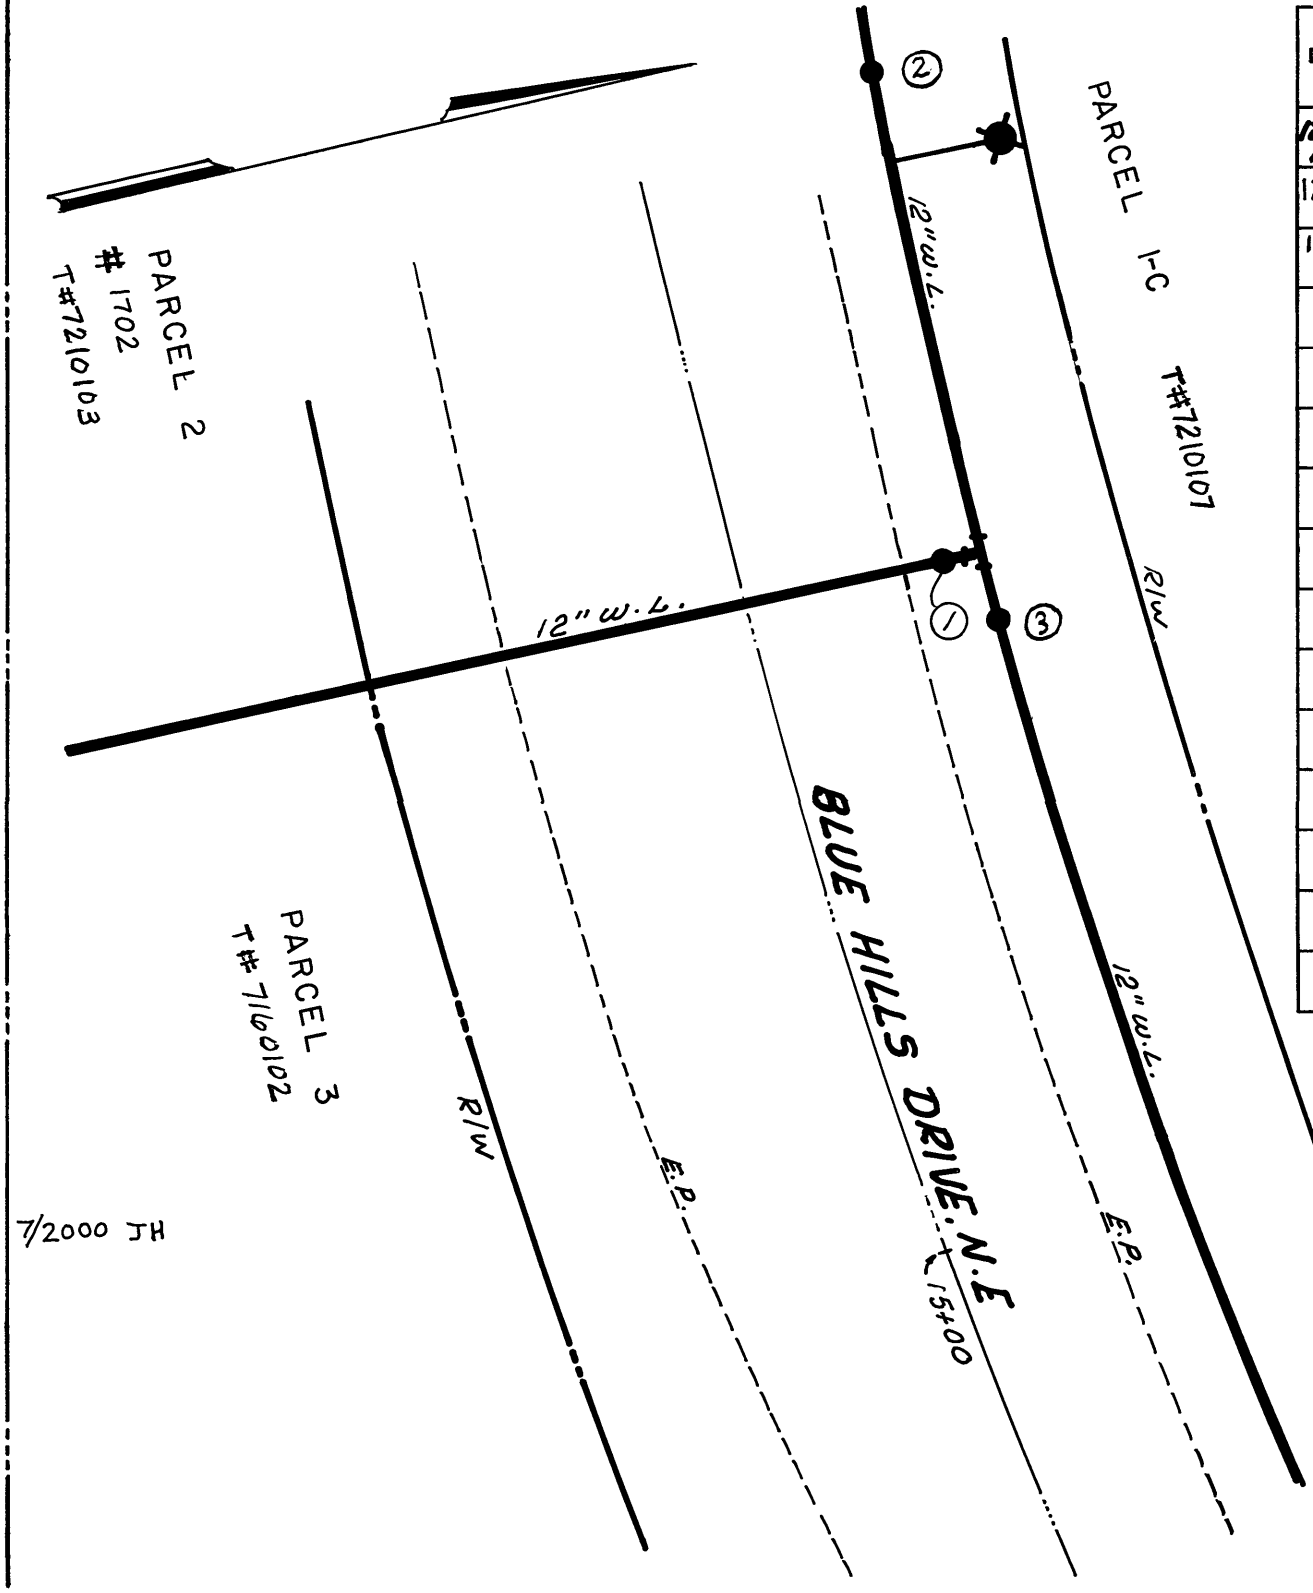

DATE	NO.	SIZE	MAKE	OPEN	TURNS
12/84	1	12"			
12/89	2	12"			
12/84	3	12"			

CITY OF ROANOKE—WATER DEP'T
VALVE DIAGRAM

1702
BLUE HILLS DRIVE, N.E.

SEC. MAP 716, 721

DATE 4-10-85 PAGE NO. 5