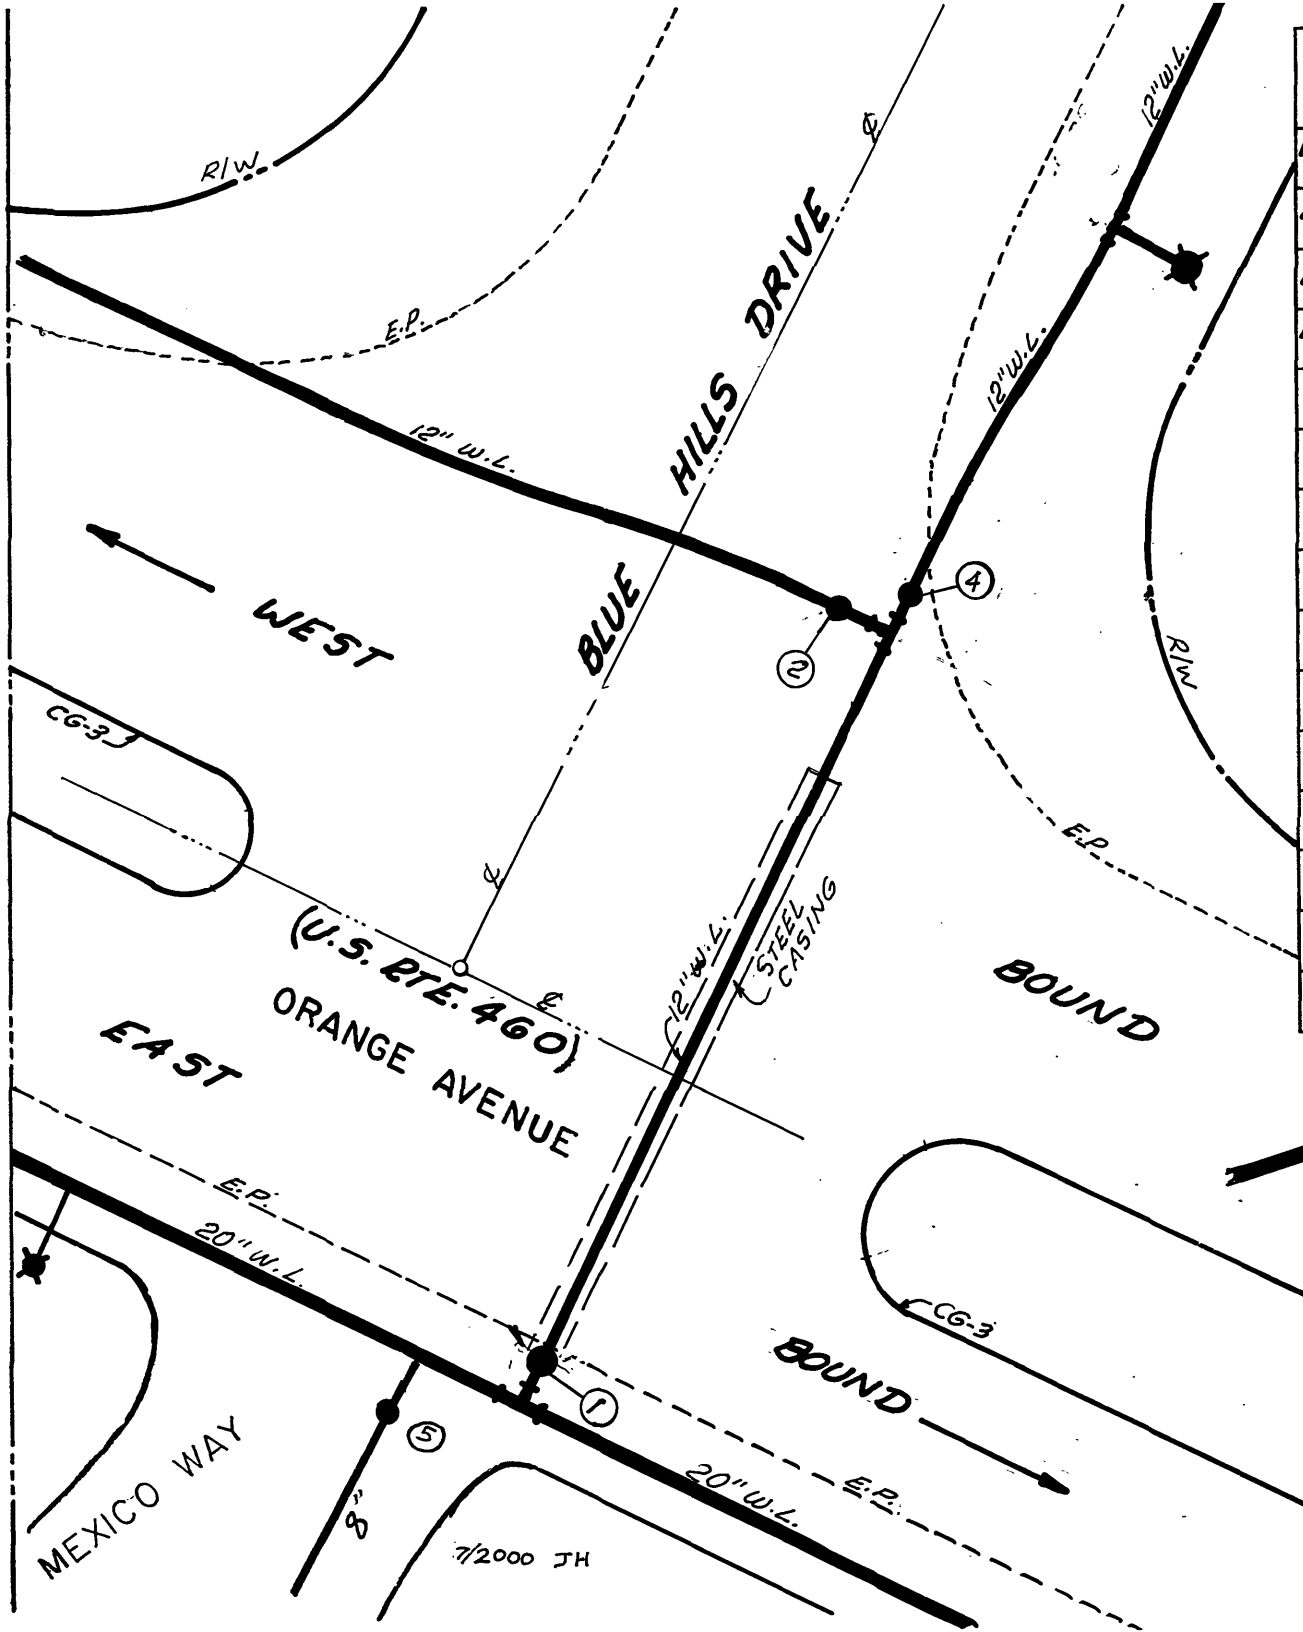

DATE	NO.	SIZE	MAKE	OPEN	TURNS
12/84	1	12"			
12/84	2	12"			
12/84	3	6"			
12/84	4	12"			
7/87	5	8"			

CITY OF ROANOKE—WATER DEP'T

VALVE DIAGRAM

ORANGE AVENUE

BLUE HILLS DRIVE, N.E.

MEXICO WAY

SEC. MAP 716

DATE 4-10-85 PAGE NO. 1