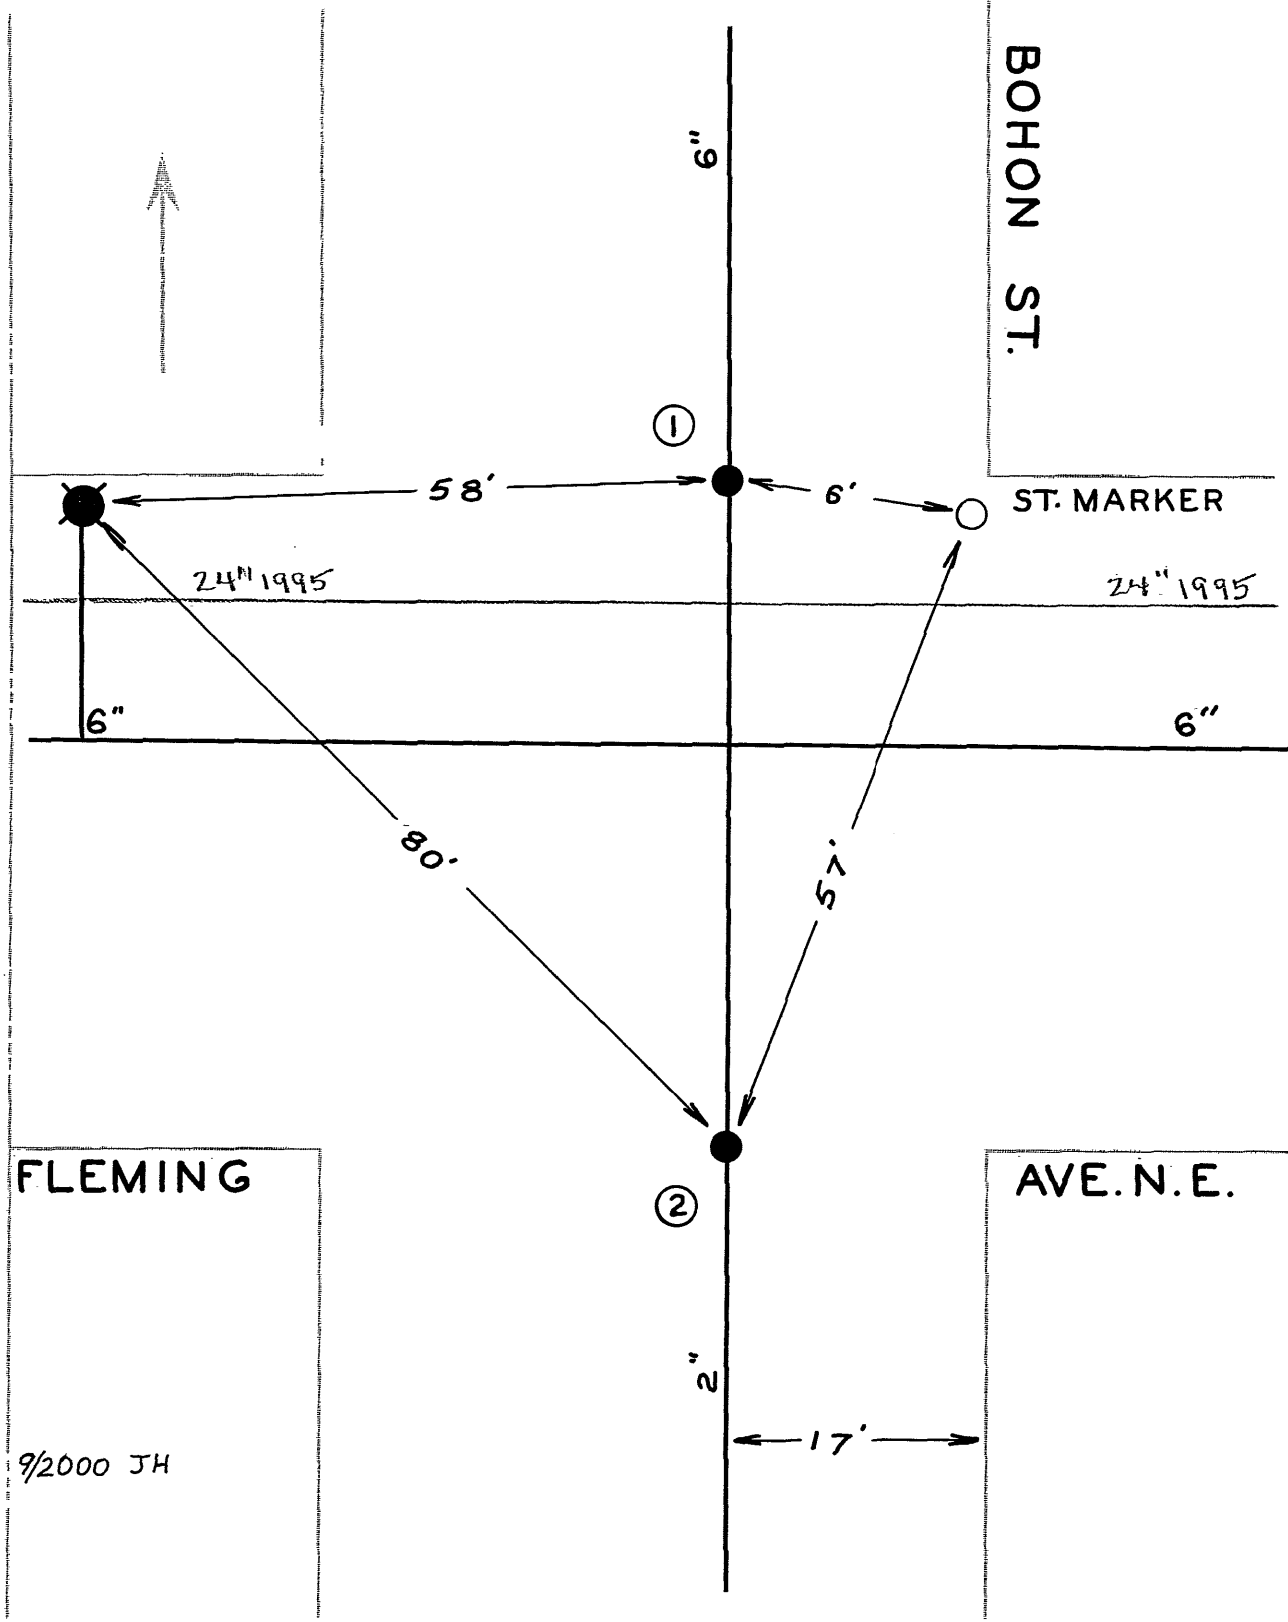

DATE	NO.	SIZE	MAKE	OPEN	TURNS
1952	1	6"			
1953	2	2"			
	1	0	NPL		
	2	0	SPL		

CITY OF ROANOKE—WATER DEPT

VALVE DIAGRAM

BOHON STREET &

FLEMING AVE.

SEC. MAP 318 N.E.

DATE PAGE NO.