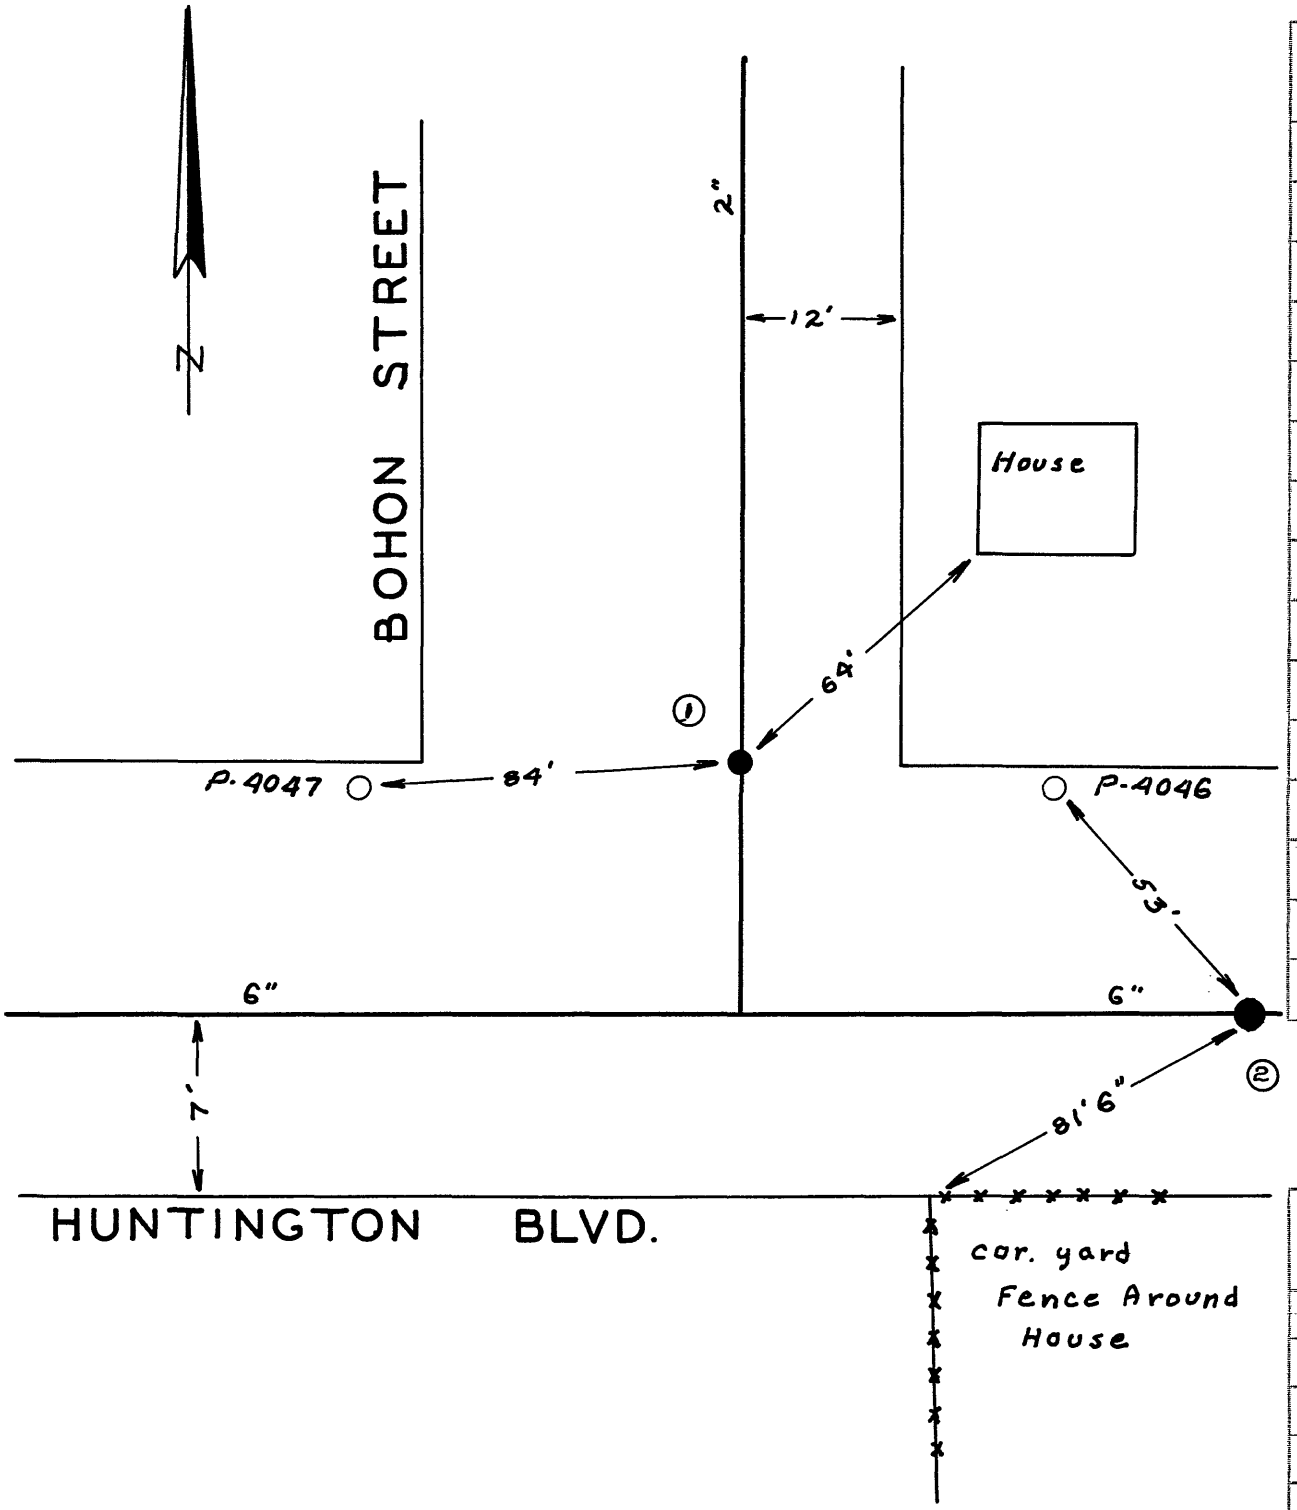

DATE	NO.	SIZE	MAKE	OPEN	TURNS
1953	1	2"			
1951	2	6"			
	1	0	NPL		
	2	103'-E	EPL		

CITY OF ROANOKE — WATER DEPT.

VALVE DIAGRAM

BOHON ST. & HUNTINGTON BLVD. N.E.

SEC. MAP 318

DATE PAGE NO.

"IMPERIAL" TRACING CLOTH K & E CO., N.Y.