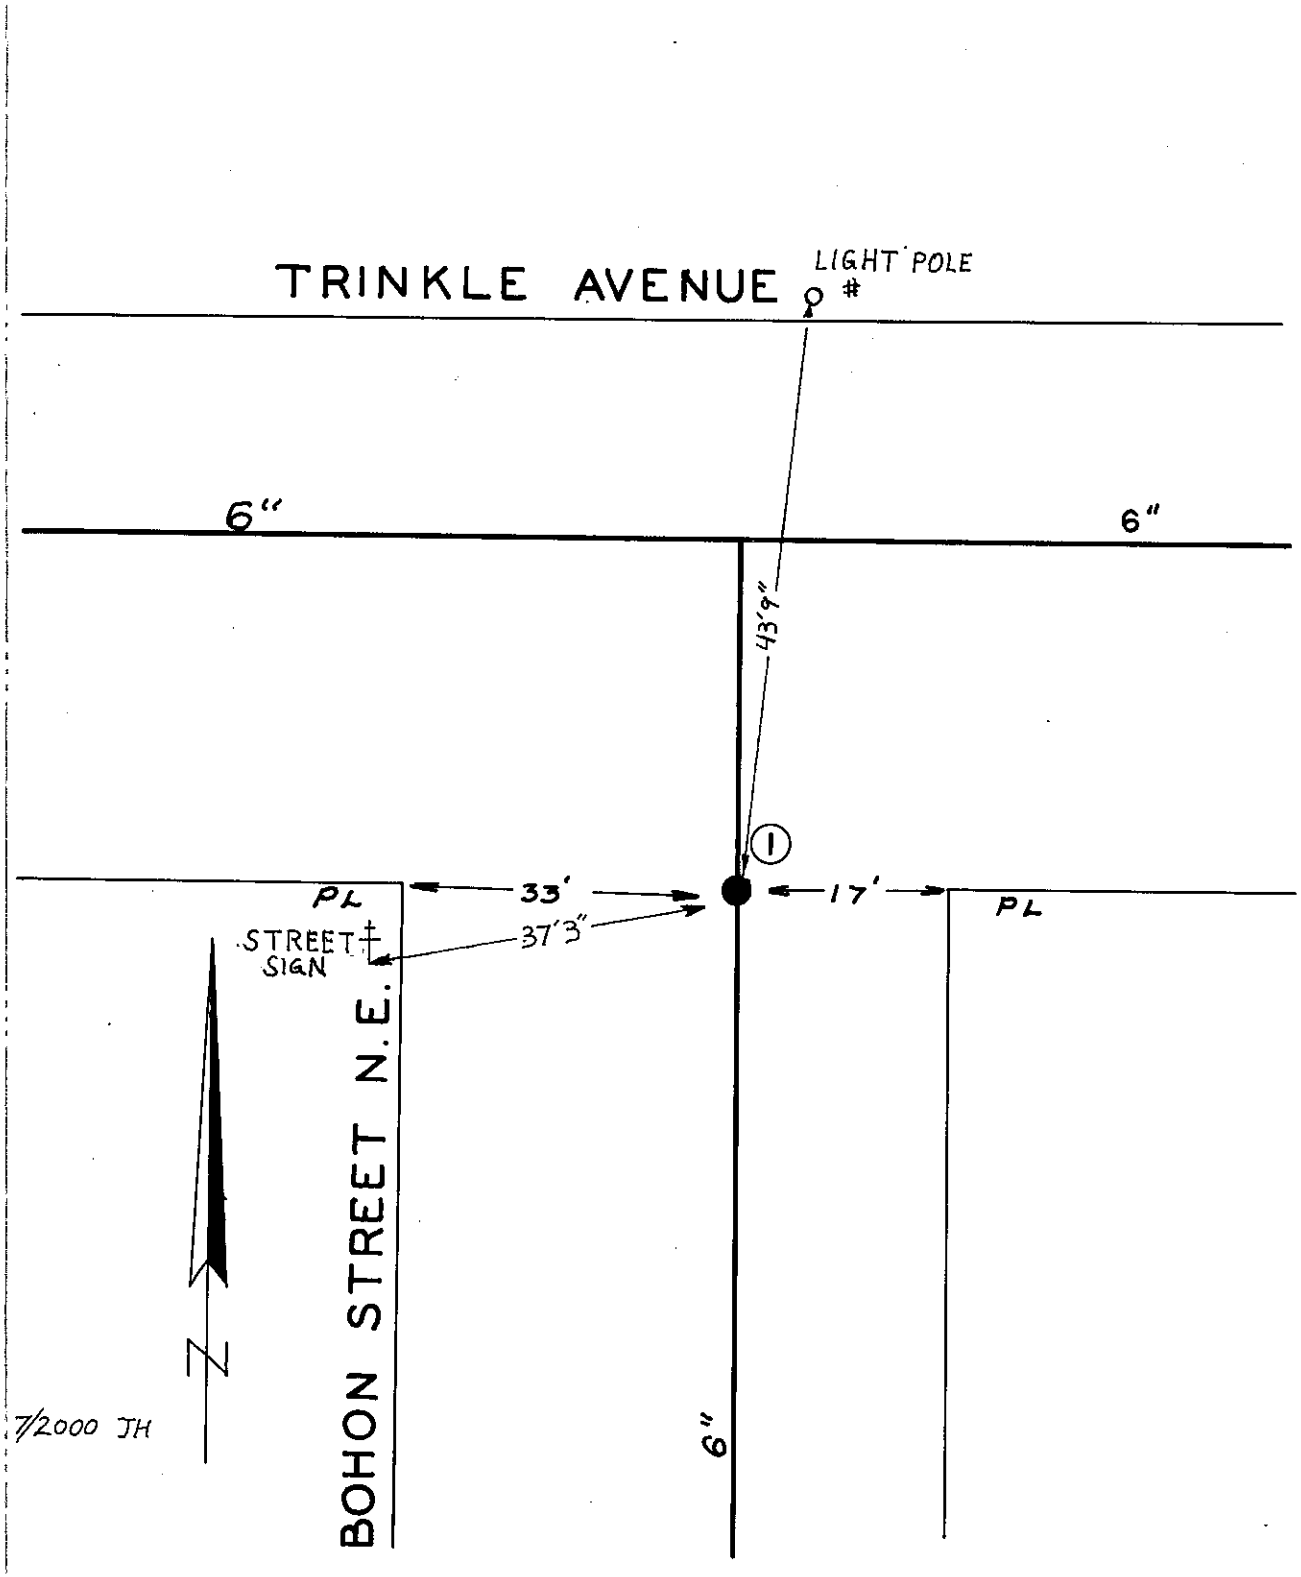

DATE	NO.	SIZE	MAKE	OPEN	TURNS
4/55	1	6"	MUELLER	R	2
	1	0	SPL		

CITY OF ROANOKE — WATER DEPT.

VALVE DIAGRAM

BOHON STREET & TRINKLE AVENUE N. E.

SEC. MAP 319

DATE PAGE NO.