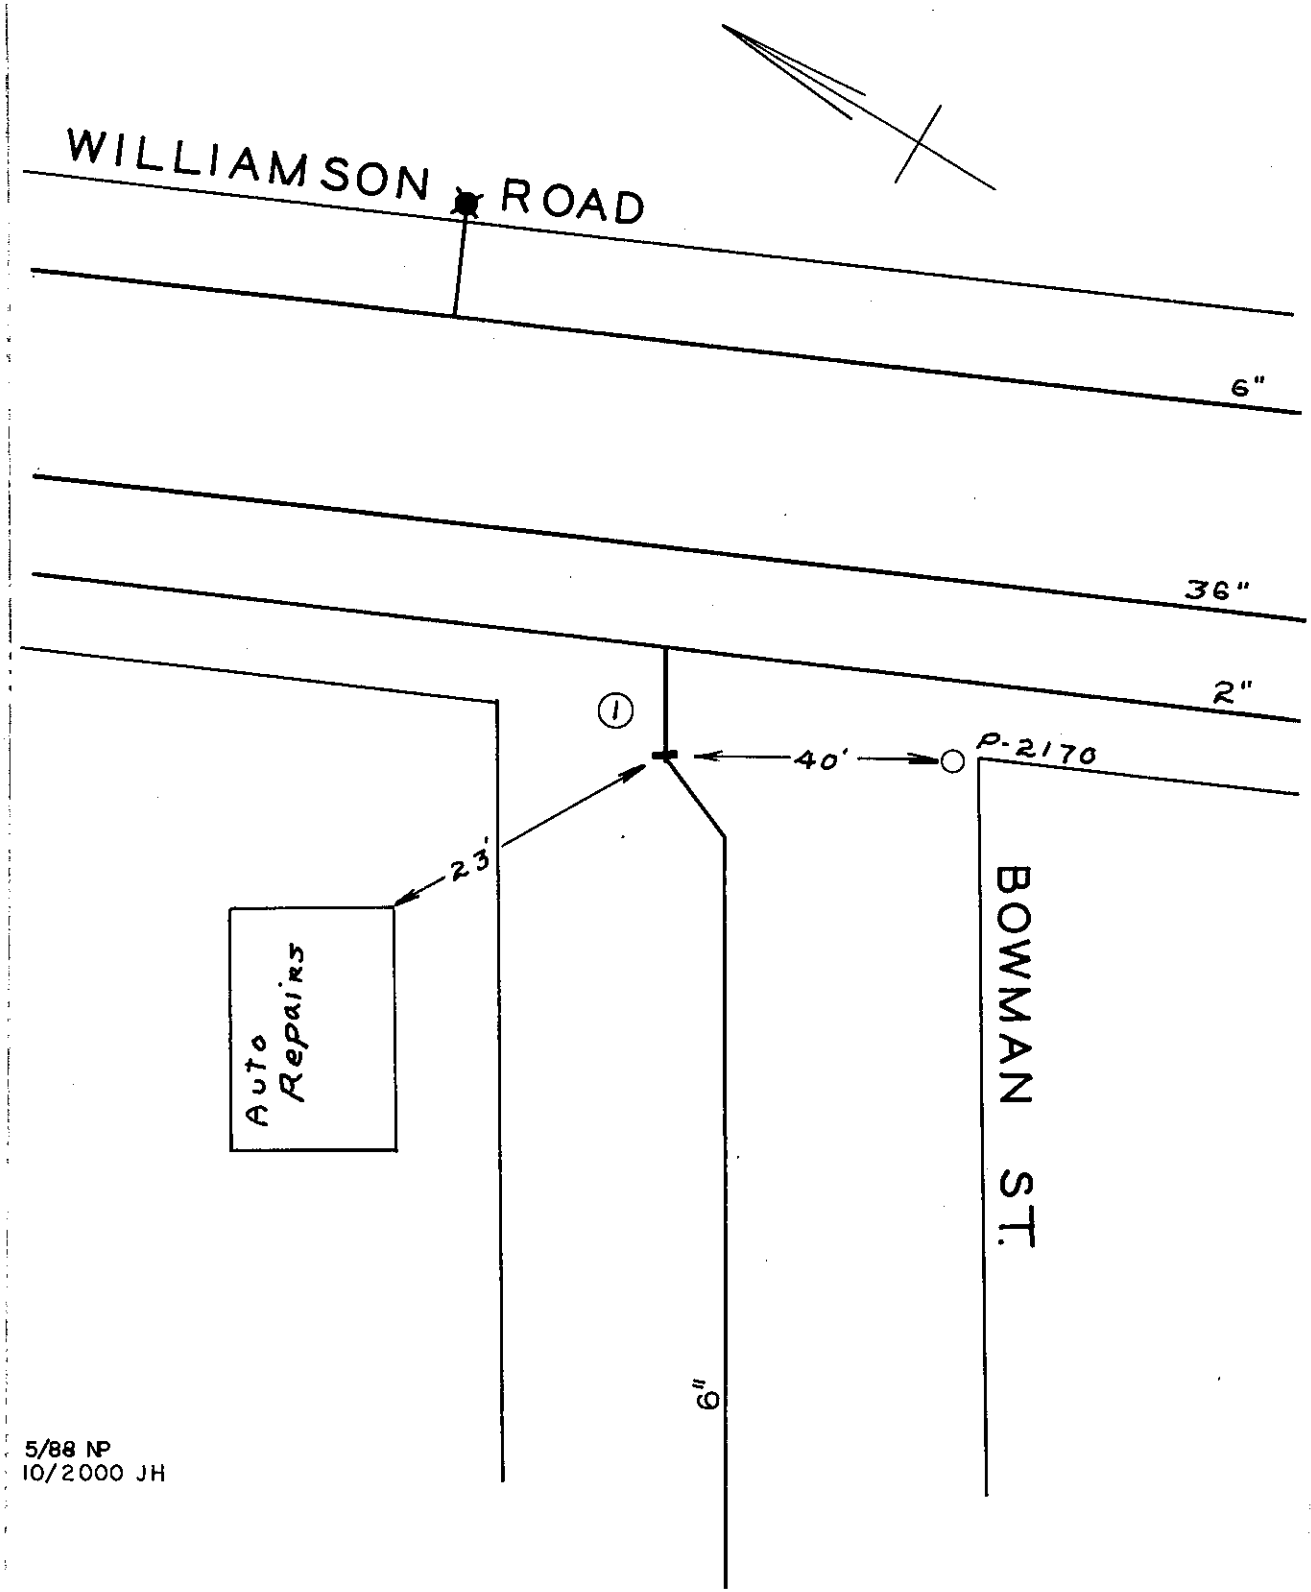

DATE	NO.	SIZE	REMARKS	WPL	TOPOG
1951	1	2"			
	1	5'-W	WPL		

BOWMAN ST. & WILLIAMSON ROAD N.W. OR N.E.

207-310

5/88 NP
10/2000 JH