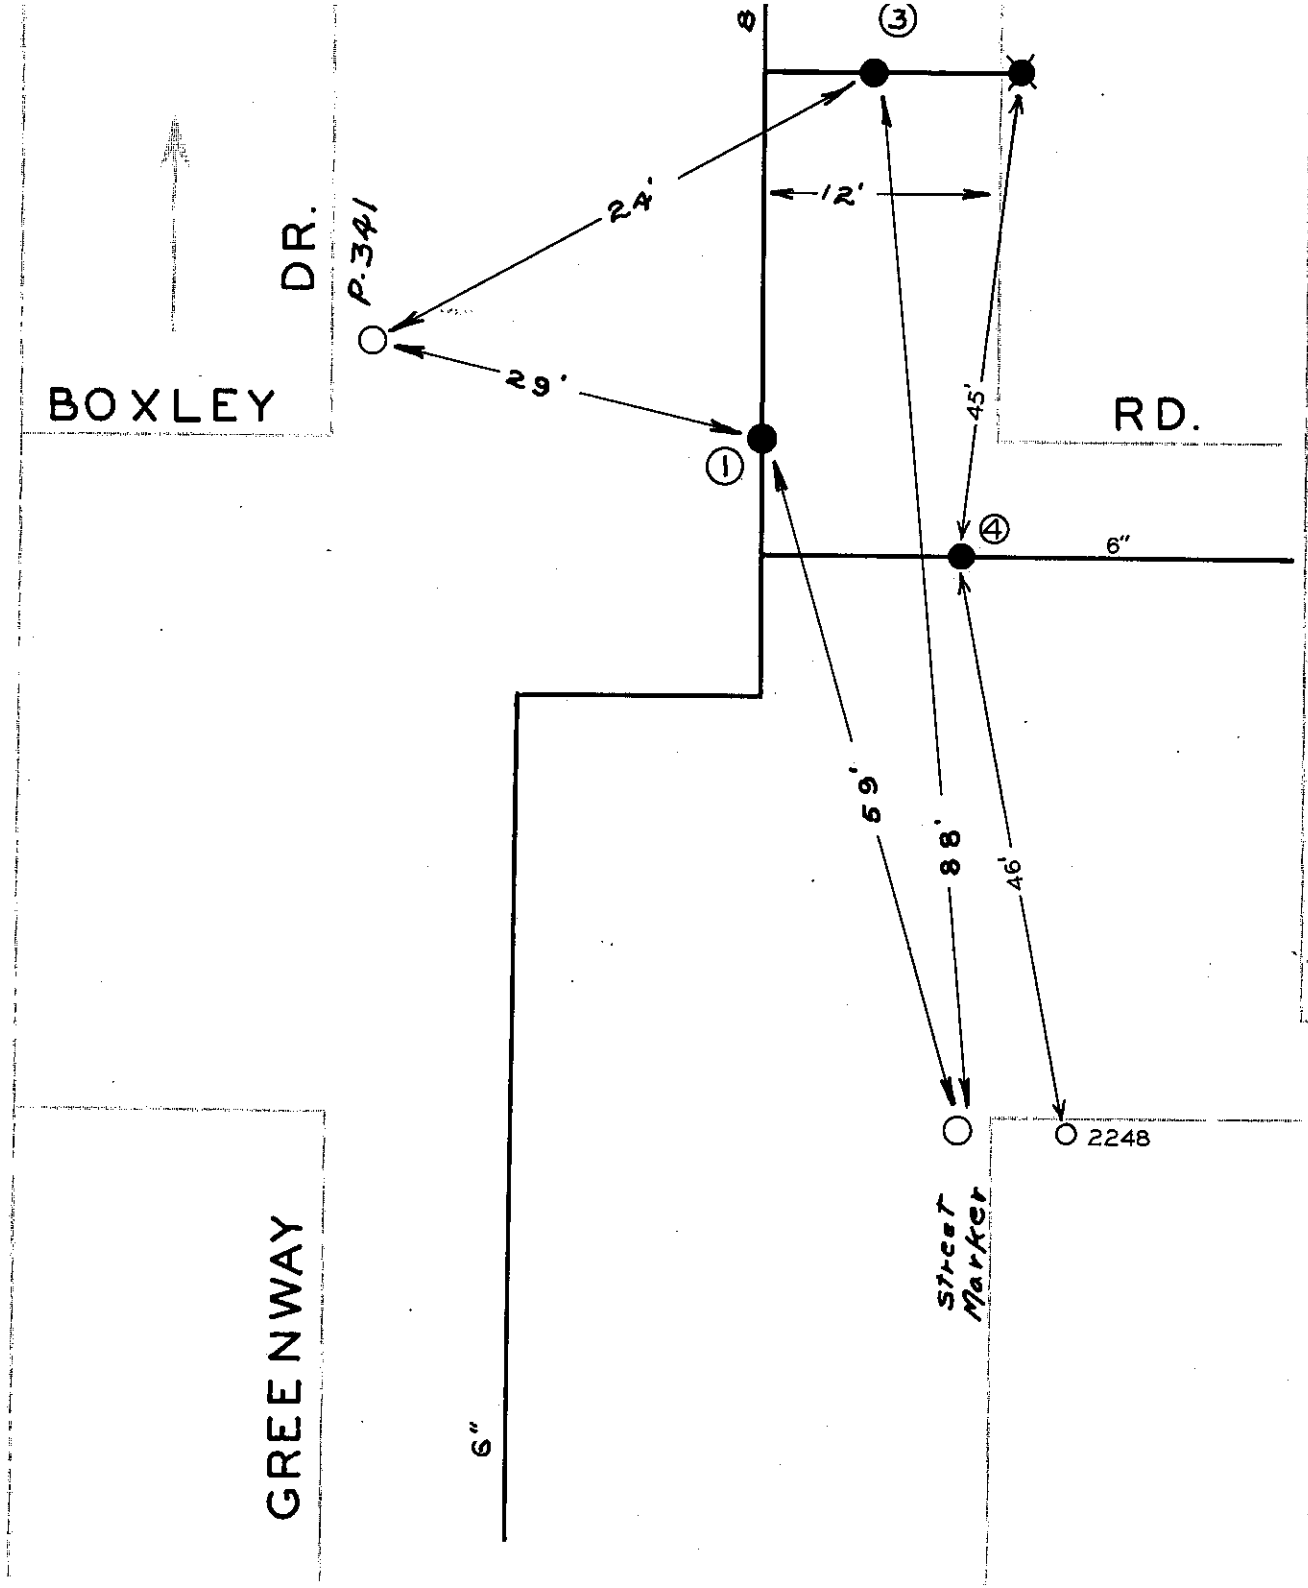

DATE	NO.	SIZE	MAKE	OPEN	TURNS
	1	8"	MUELLER	R	28
	3	6"	H-Stub		
9-71	4	6"	DARLING	R	
	1	0	NPL		
	2	22'-W	EPL		

CITY OF ROANOKE — WATER DEP'T

VALVE DIAGRAM

BOXLEY RD. & GREENWAY DRIVE N.E.

SEC MAP 16 Roanoke County

DATE: PAGE No.