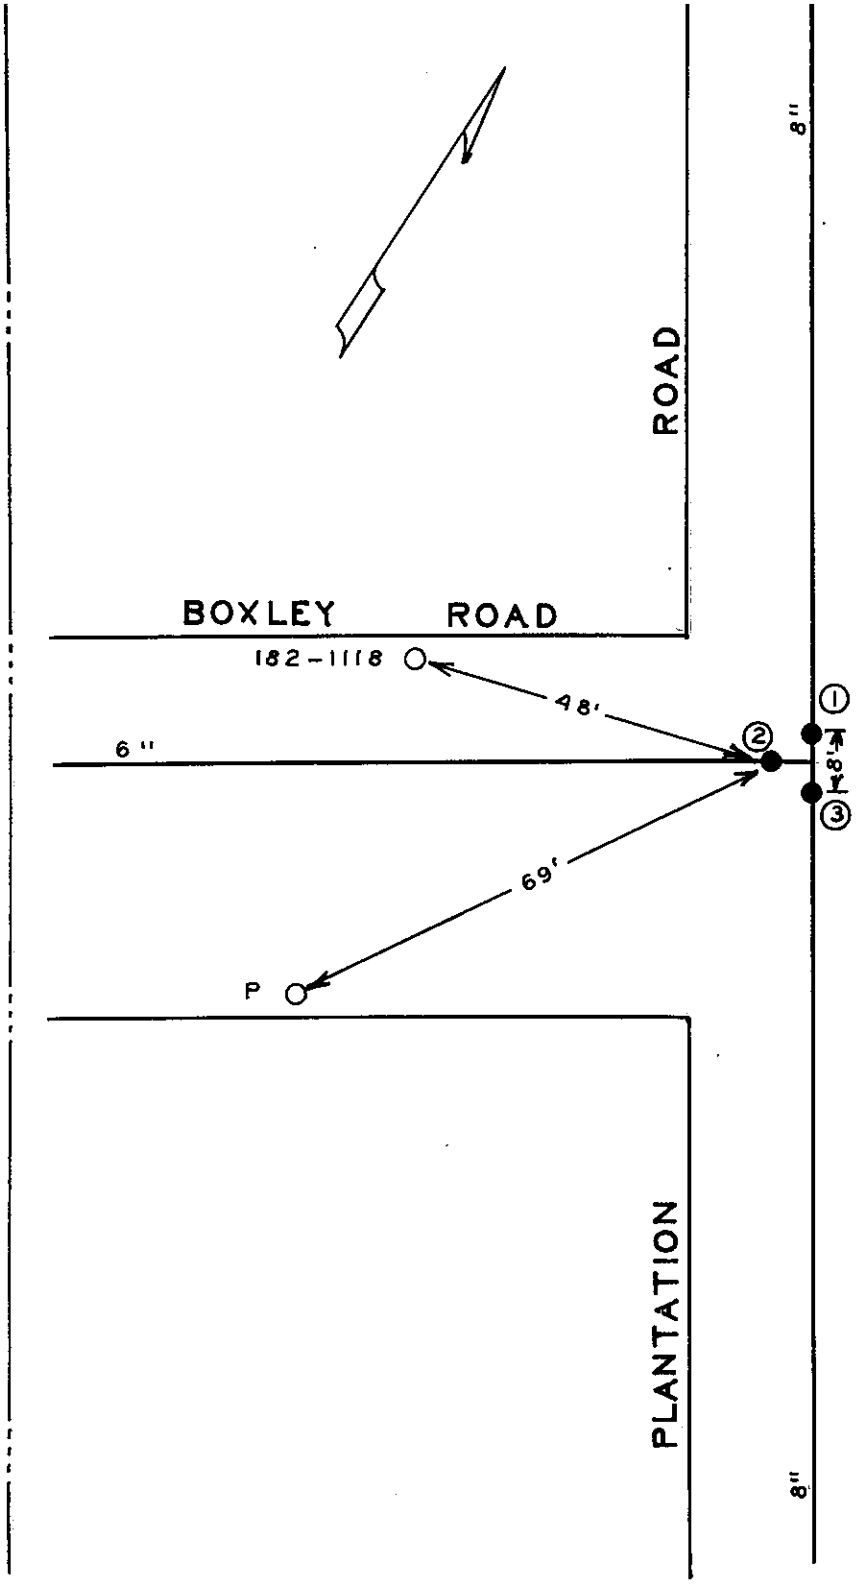

DATE	NO.	SIZE	MAKE	OPEN	TURNS
6-66	1	8"	MUELLER	R	
6-66	2	6	MUELLER	R	
6-66	3	8	MUELLER	R	

CITY OF ROANOKE—WATER DEPT.

VALVE DIAGRAM

BOXLEY ROAD &

PLANTATION ROAD N.E.

SEC. MAP 19 Roanoke County

DATE **PAGE NO.**