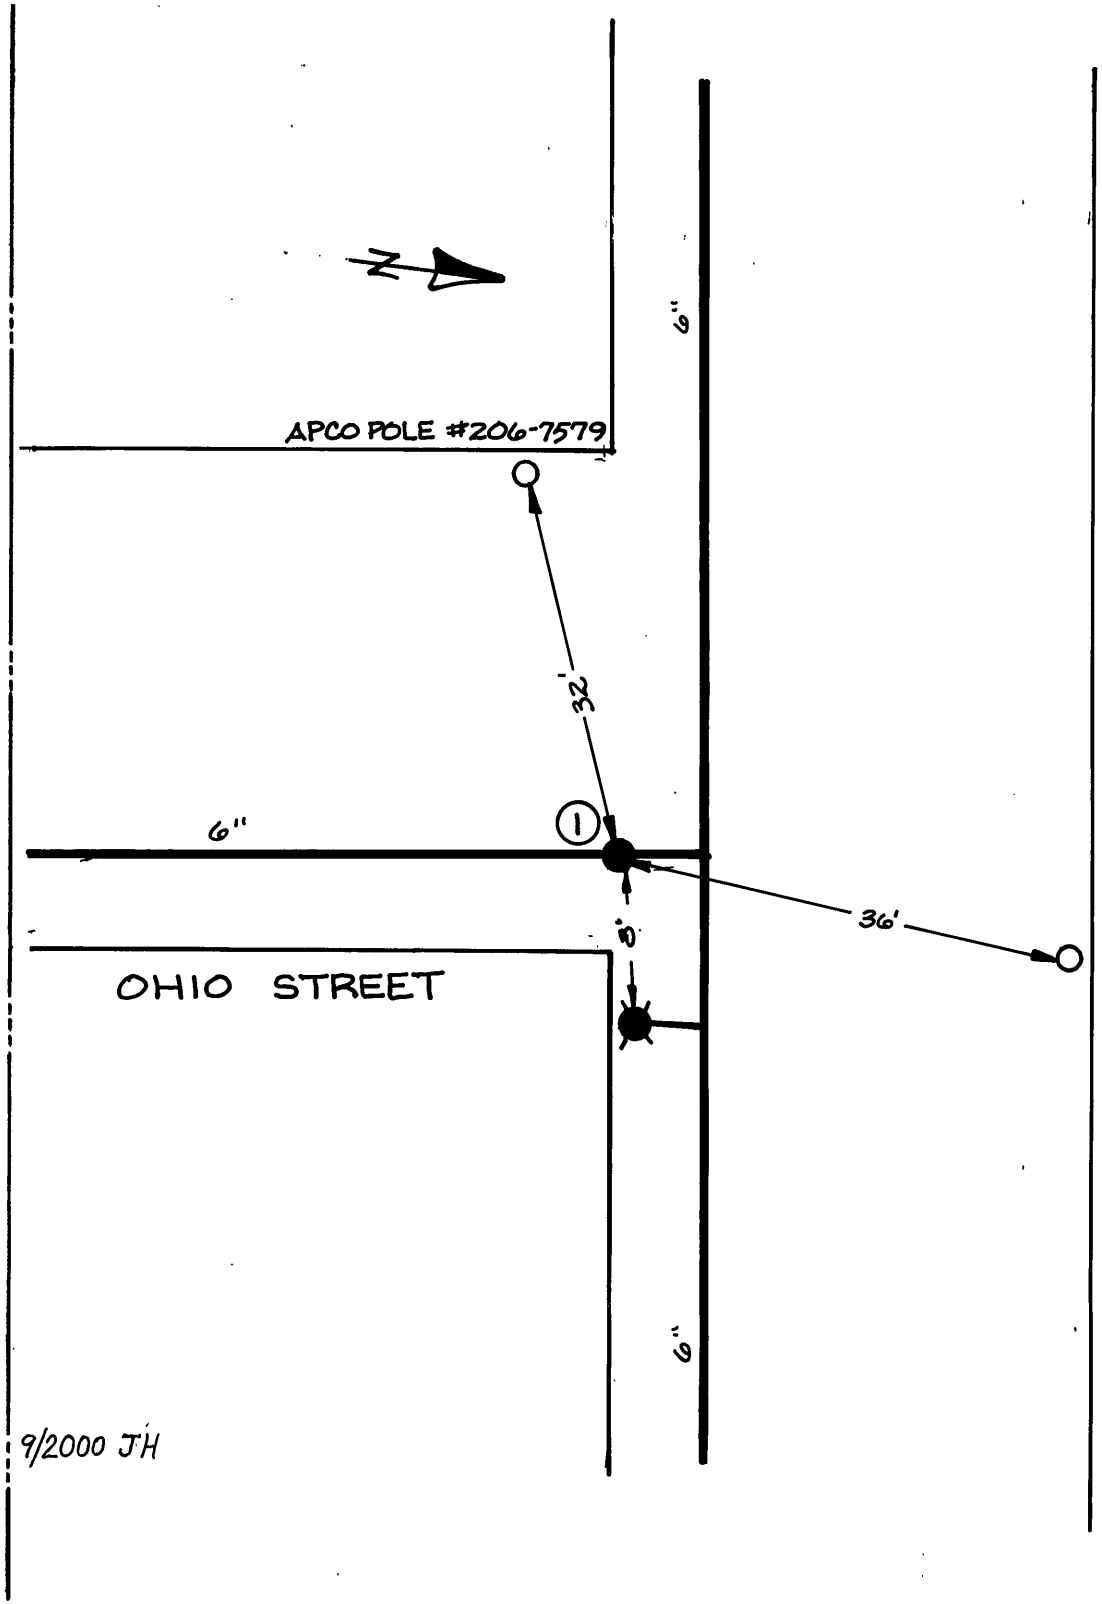

DATE	NO.	SIZE	MAKE	OPEN	TURNS
12-82	1	6"		R	21

CITY OF ROANOKE—WATER DEP'T

VALVE DIAGRAM

BRADFORD ST. AND

OHIO ST.

N.E.

SEC. MAP 736

DATE PAGE NO.