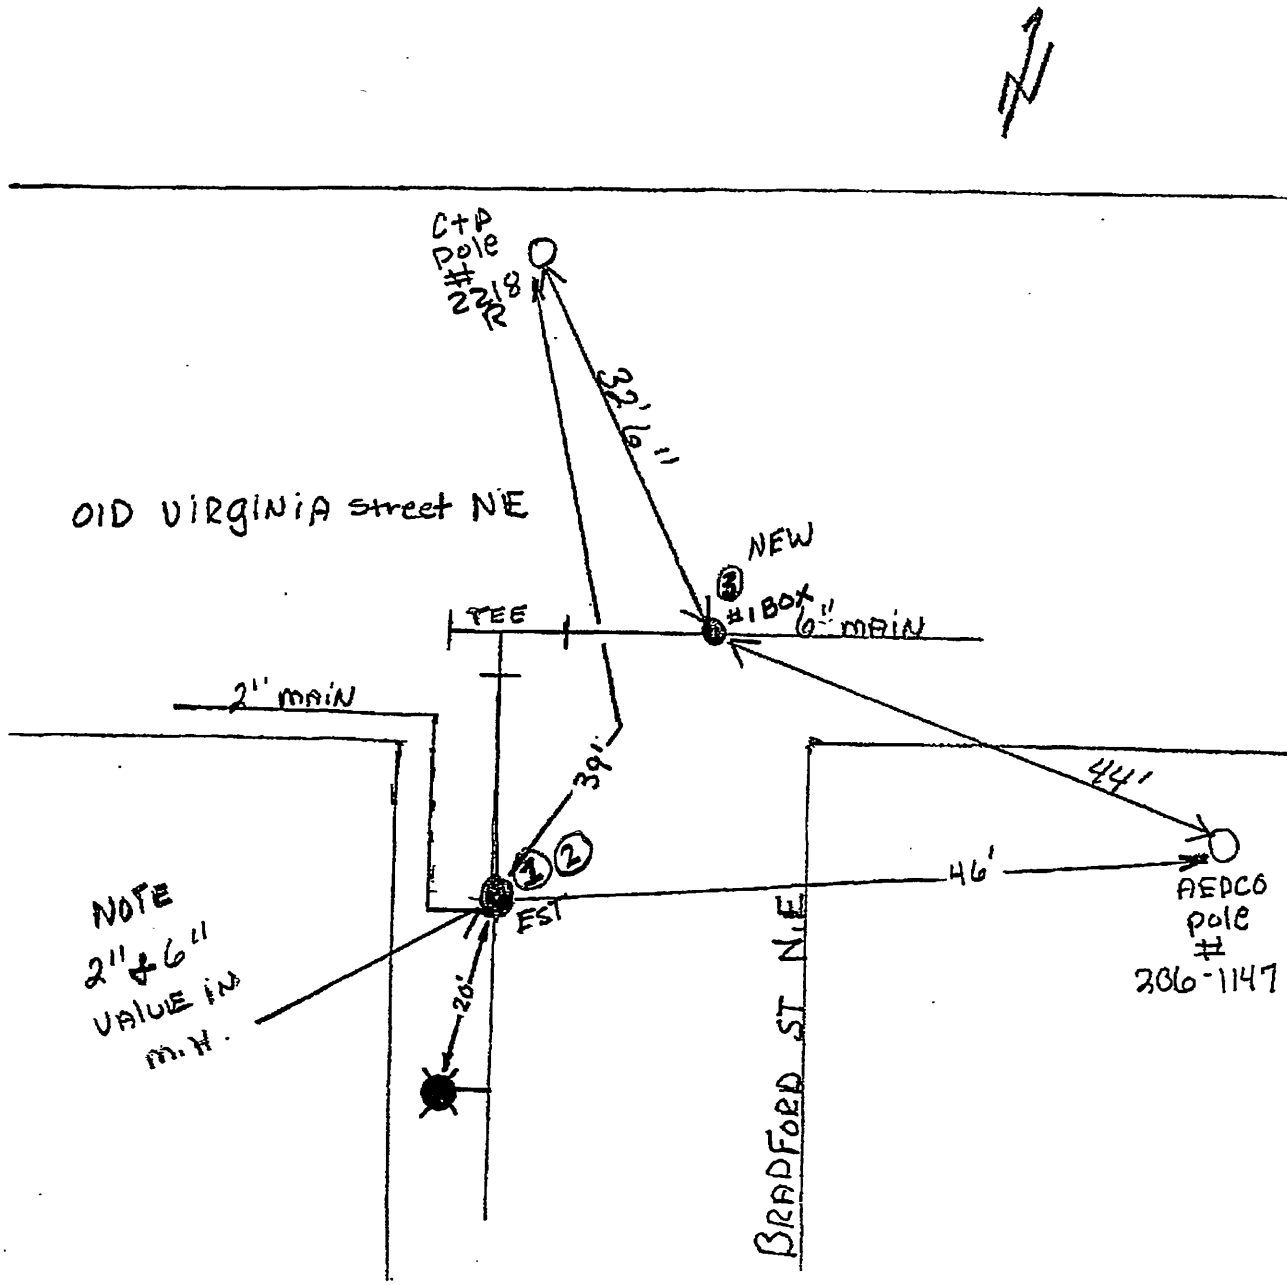

DATE	NO.	SIZE	MAKE	OPEN	TURNS
4-03	3	6"		R	21
12-82	1	6"		R	21
12-82	2	2"		L	
	1	6"	7' E of EPL		
	2	2"	O. EPL		

P. L. Measurements

No.	Distance	Direction

CITY OF ROANOKE - WATER DEPT.
VALVE DIAGRAM

BRADFORD ST NE.
OLD VIRGINIA ST. N.E.

Sec. Map 736

Date Page No.