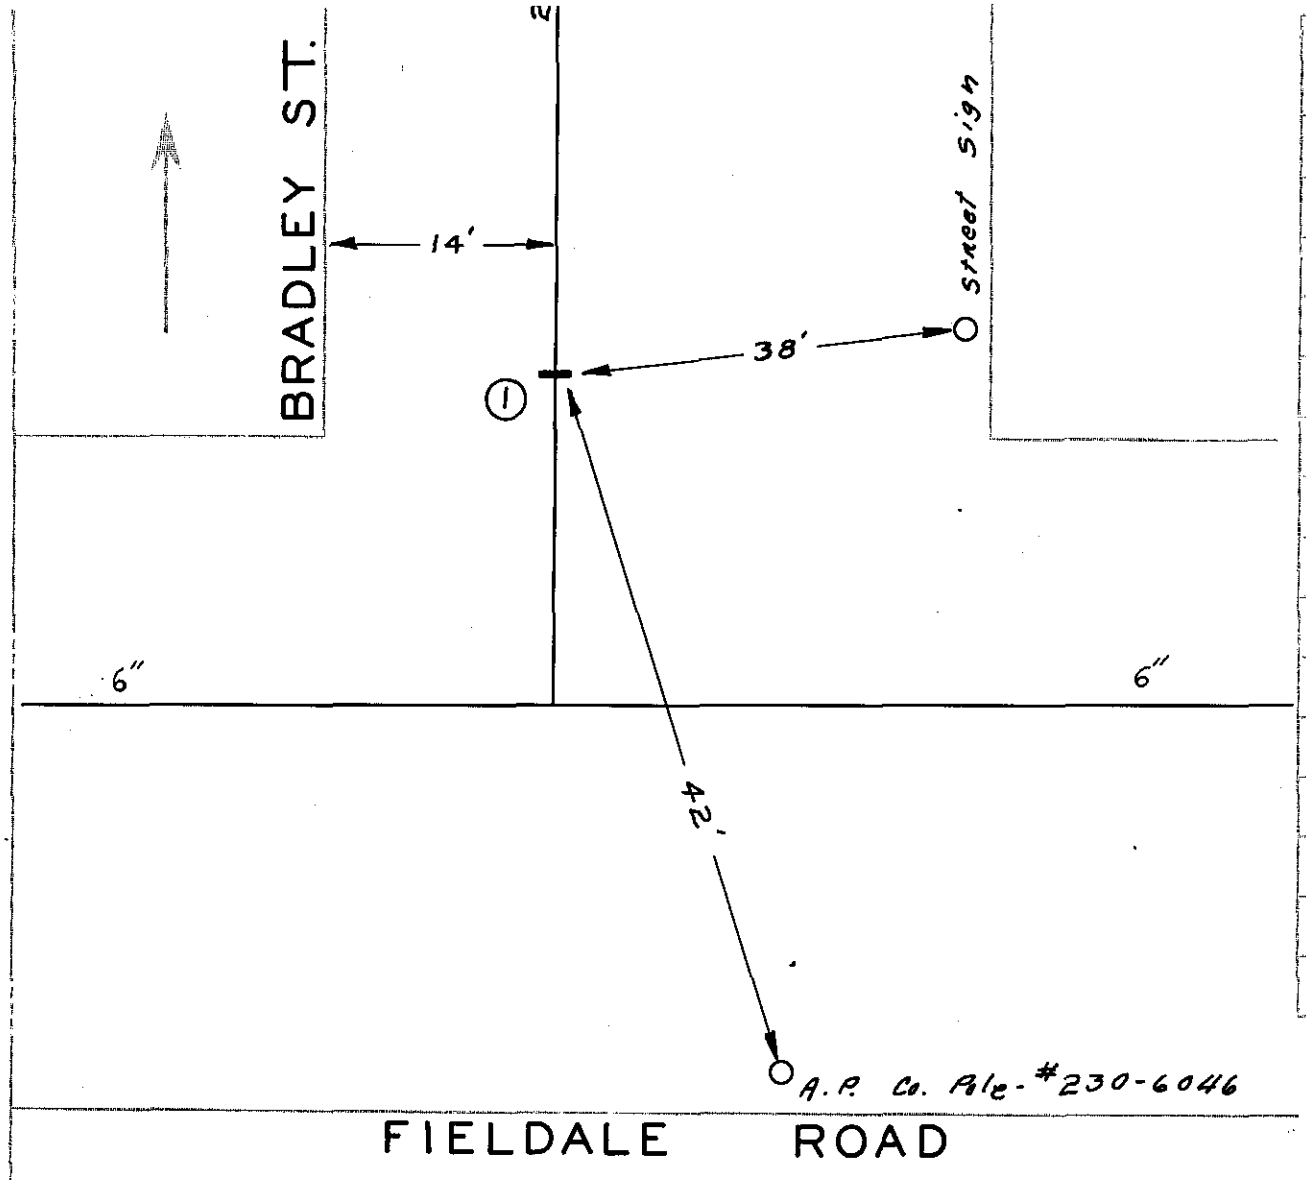

DATE	NO	SIZE	MAKE	OPEN	TURNS
'58	1	2"	MISC.	L	
	1	4'-N	NPL		

9/2000 JH

CITY OF ROANOKE - WATER DEP'T

VALVE DIAGRAM

BRADLEY ST. &

FIELDALE ROAD

SEC MAP 310 N.E.

DATE PAGE NO