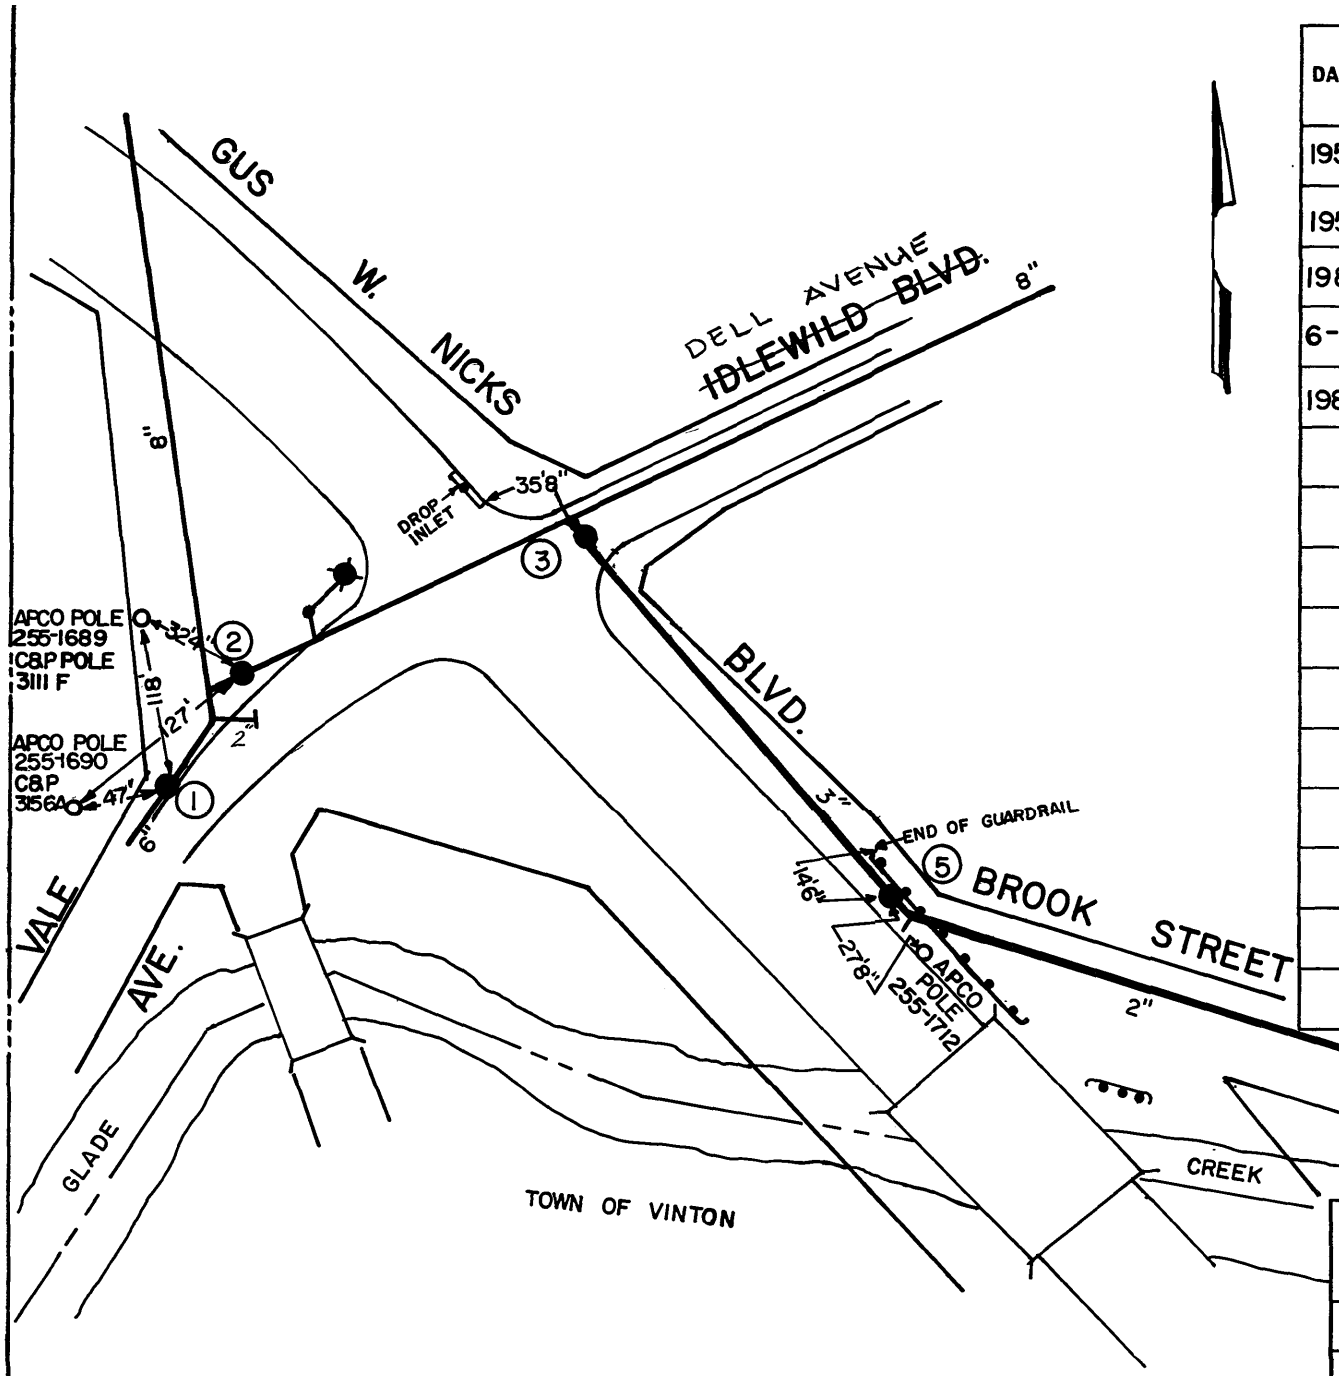

DATE	NO.	SIZE	MAKE	OPEN	TURNS
1952	1	6"	MUELLER	R	20
1952	2	8"	MUELLER	R	26
1981	3	6"			
6-88	4	1"	BLOW OFF		
1981	5	6"			

(4) - BLOW OFF IN METER BOX.
1" CURB STOP IN THE METER BOX.
1" COPPER PIPE IS STUBBED OUT OF METER BOX W/1" PLUG ON THE END ON WEST SIDE OF BOX.

2/90 NP
9/2000 JH

CITY OF ROANOKE—WATER DEP'T

VALVE DIAGRAM

BROOK ST., DELL AVE. GUS W. NICKS BLVD.,

~~IDLEWILD BLVD~~, VALE AVE.

N.E.

SEC. MAP 332, 341

DATE PAGE NO.