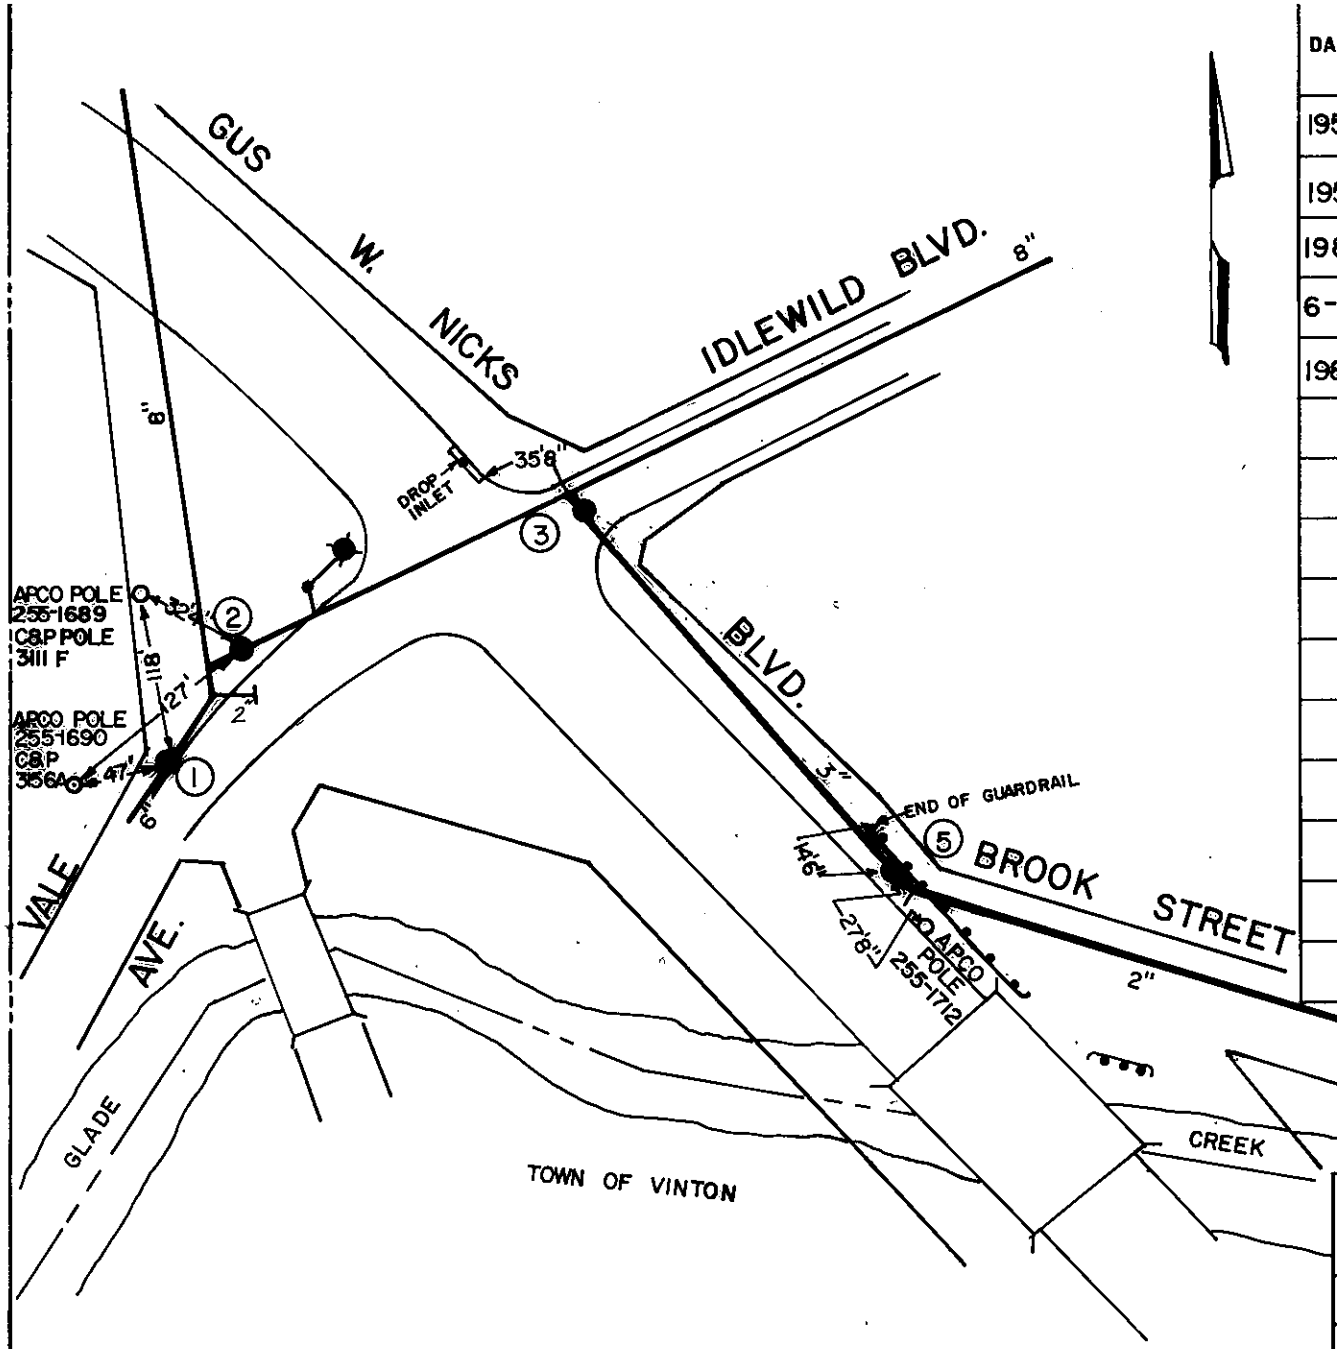

DATE	NO.	SIZE	MAKE	OPEN	TURNS
1952	1	6"	MUELLER	R	20
1952	2	8"	MUELLER	R	26
1981	3	6"			
6-88	4	1"	BLOW OFF		
1981	5	6"			

④ - BLOW OFF IN METER BOX.
1" CURB STOP IN THE METER BOX.
1" COPPER PIPE IS STUBBED OUT OF METER BOX W/1" PLUG ON THE END ON WEST SIDE OF BOX.

CITY OF ROANOKE—WATER DEP'T

VALVE DIAGRAM

BROOK ST., GUS W. NICKS BLVD, IDLEWILD BLVD, VALE AVE.

N.E.

SEC. MAP 332, 341

DATE PAGE NO.

2/90 NP
9/2000 JH