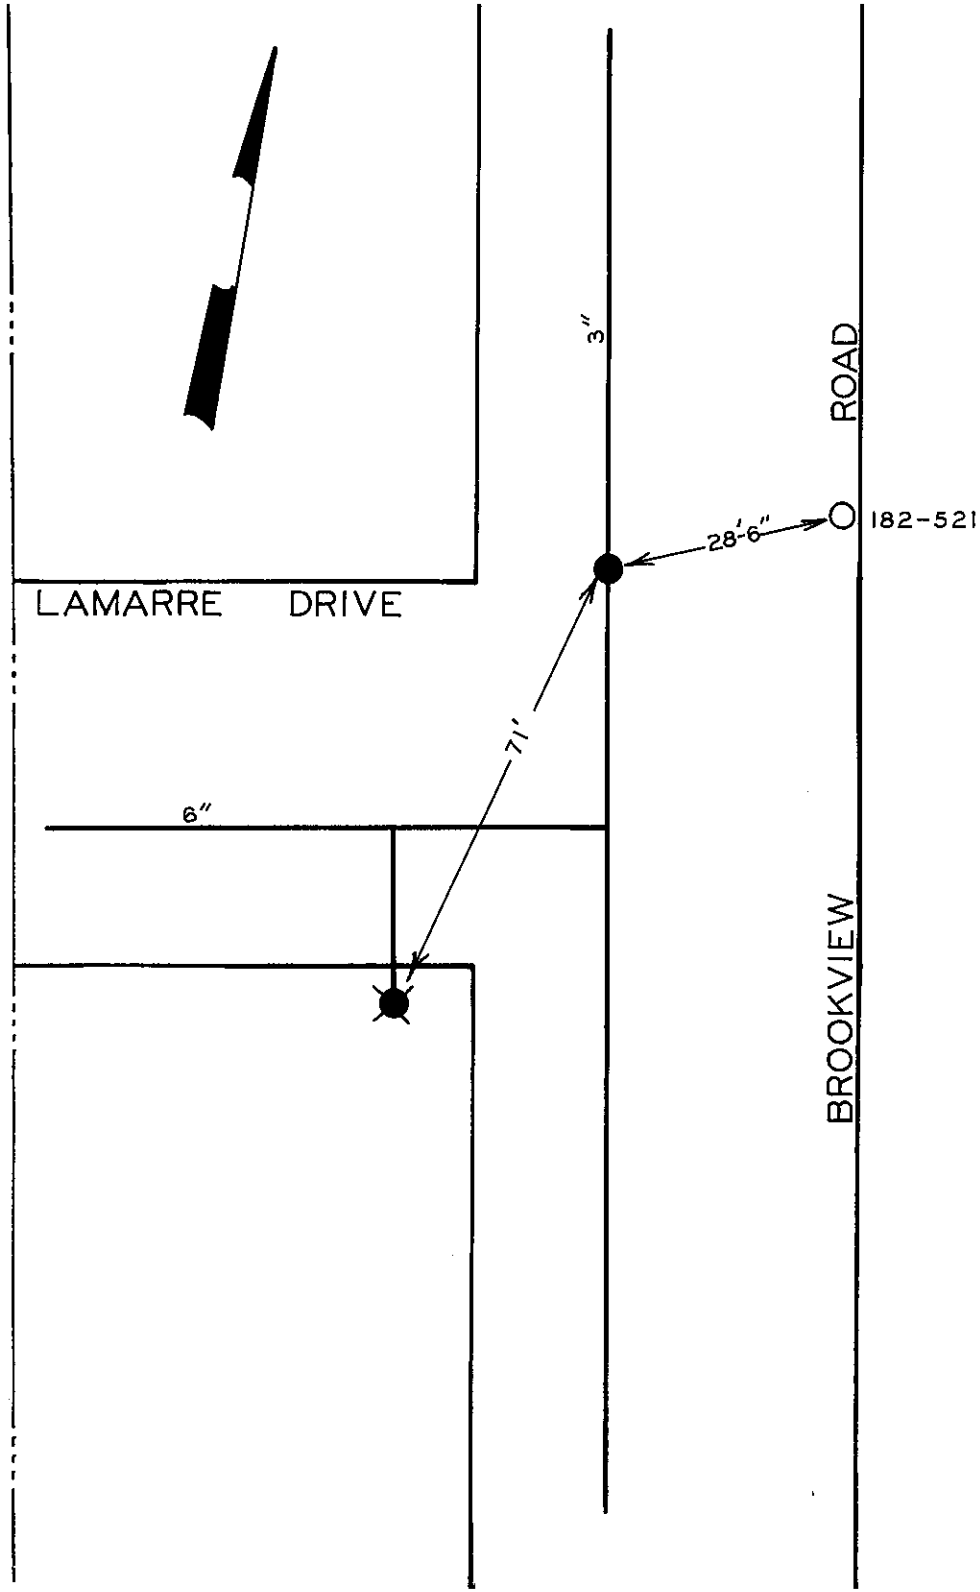

DATE	NO.	SIZE	MAKE	OPEN	TURNS
10-68	1	3	MUELLER	R	12

CITY OF ROANOKE—WATER DEPT.

VALVE DIAGRAM

BROOKVIEW RD. & LAMARRE DR. N.E.

SEC. MAP 58 Roanoke County

DATE **PAGE NO.**