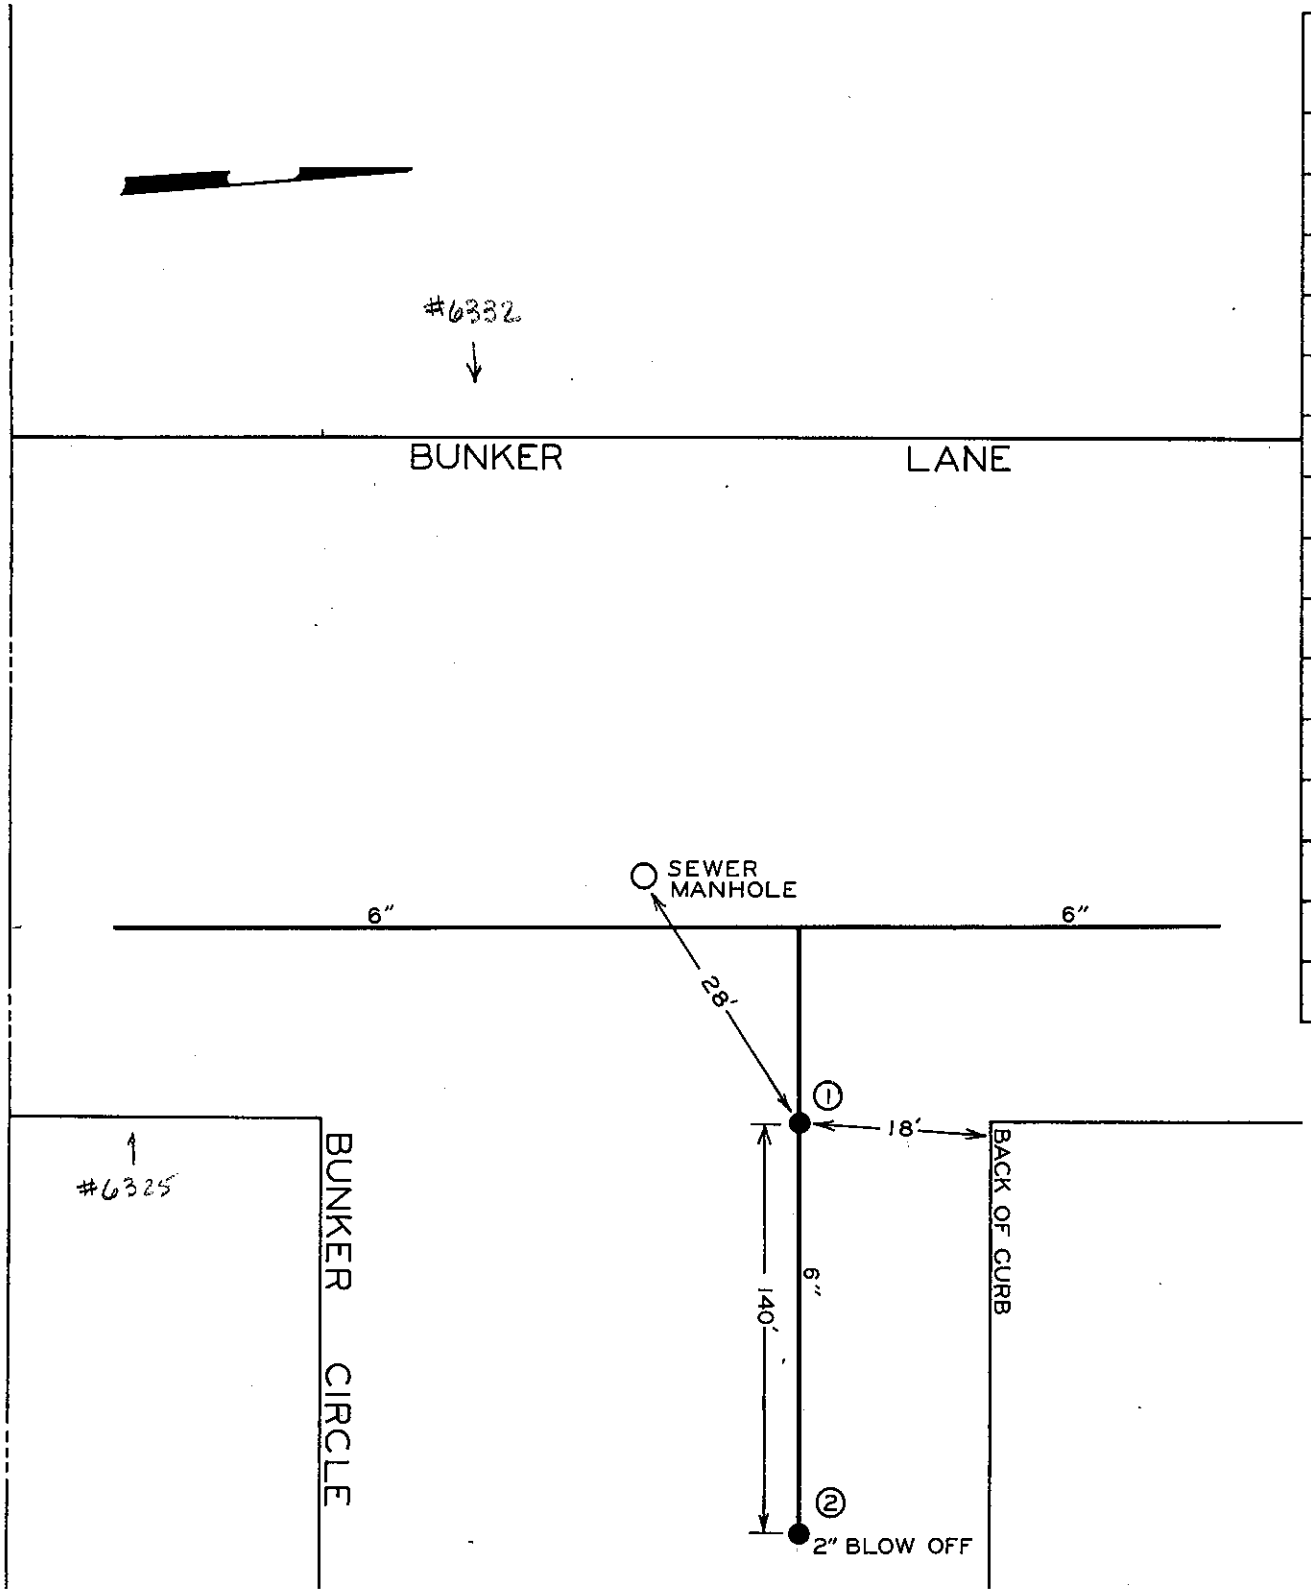


| DATE | NO. | SIZE | MAKE | OPEN | TURNS |
|---|---|---|---|---|---|
| 69 | 1 | 6" | MUELLER | R | |
| 69 | 2 | 2" | MISC. | L | |
| | | | | | |
| | | | | | |
CITY OF ROANOKE—WATER DEP'T

**VALVE DIAGRAM**

BUNKER CIR. & BUNKER LA. N.E.

SEC. MAP 1 . Roanoke County

DATE PAGE NO.