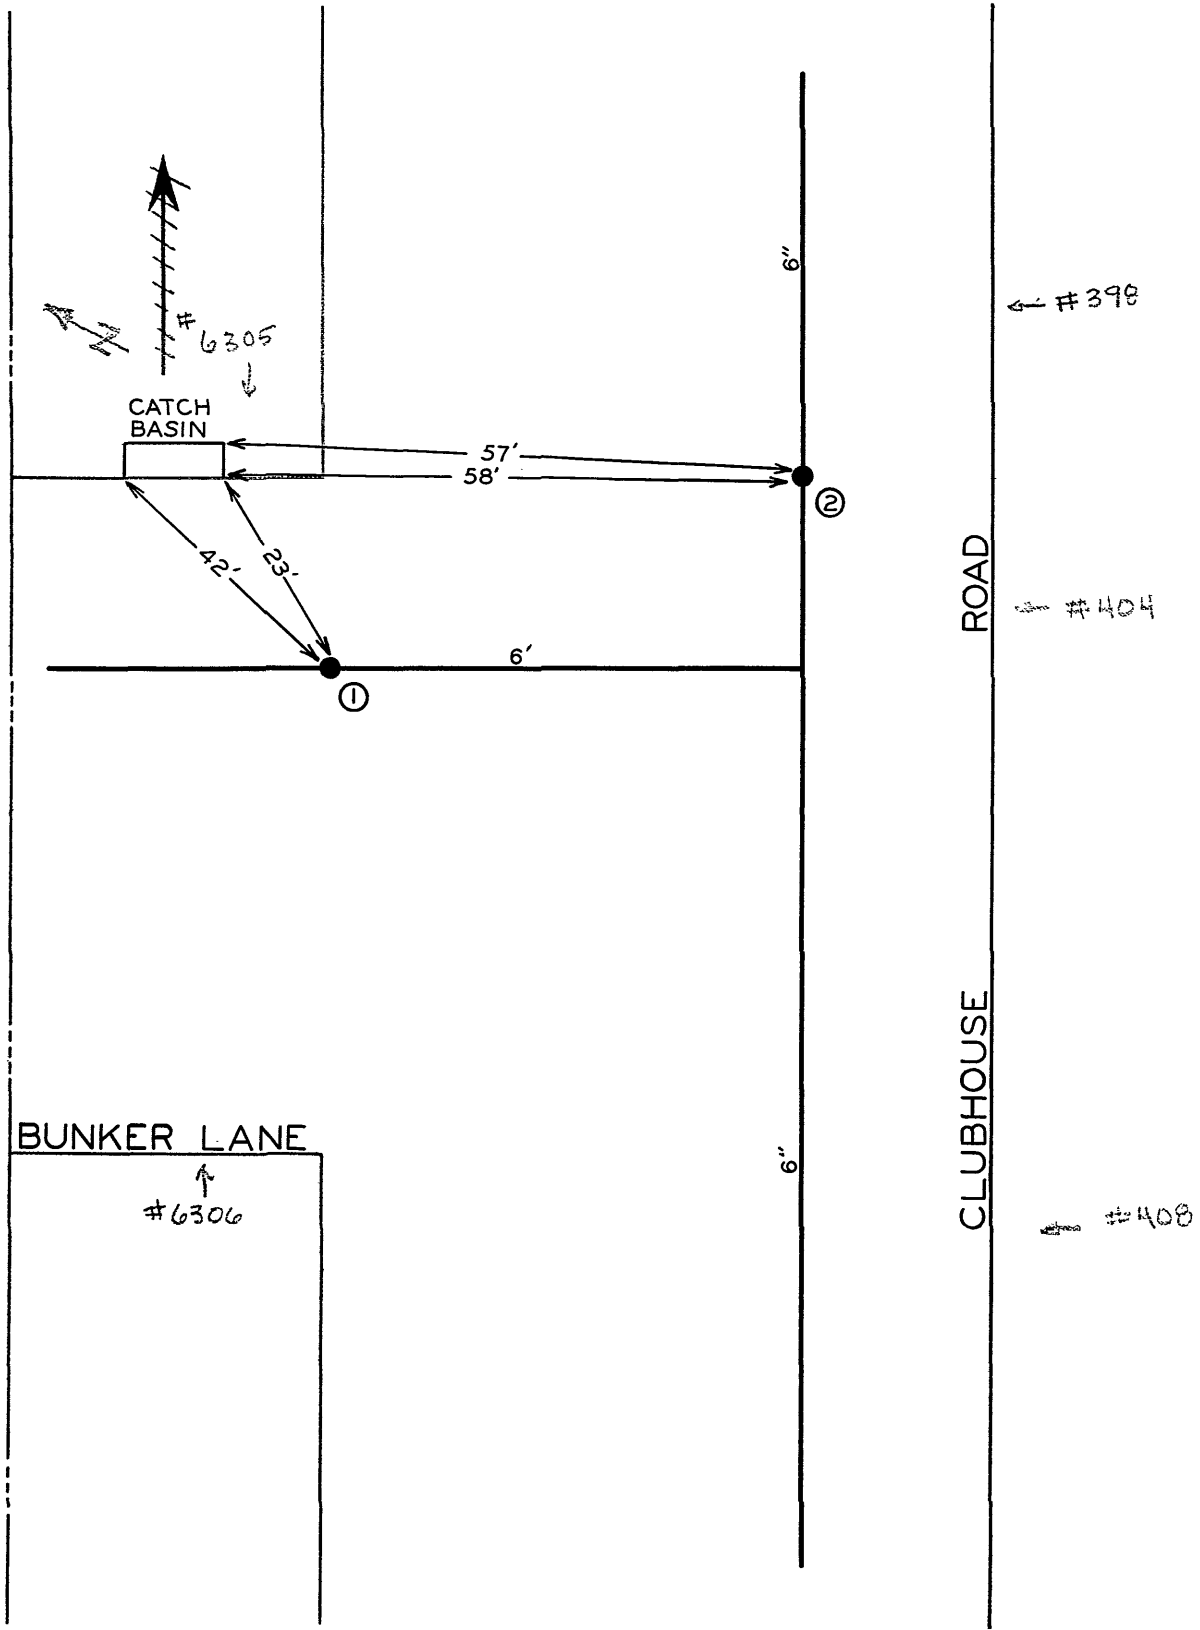

DATE	NO.	SIZE	MAKE	OPEN	TURNS
69	1	6"	MUELLER	R	
69	2	6"	MUELLER	R	

CITY OF ROANOKE—WATER DEP'T

VALVE DIAGRAM

BUNKER LANE & CLUBHOUSE ROAD N.E.

SOUTH INTERSECTION

SEC. MAP 1 Roanoke County

DATE PAGE NO.