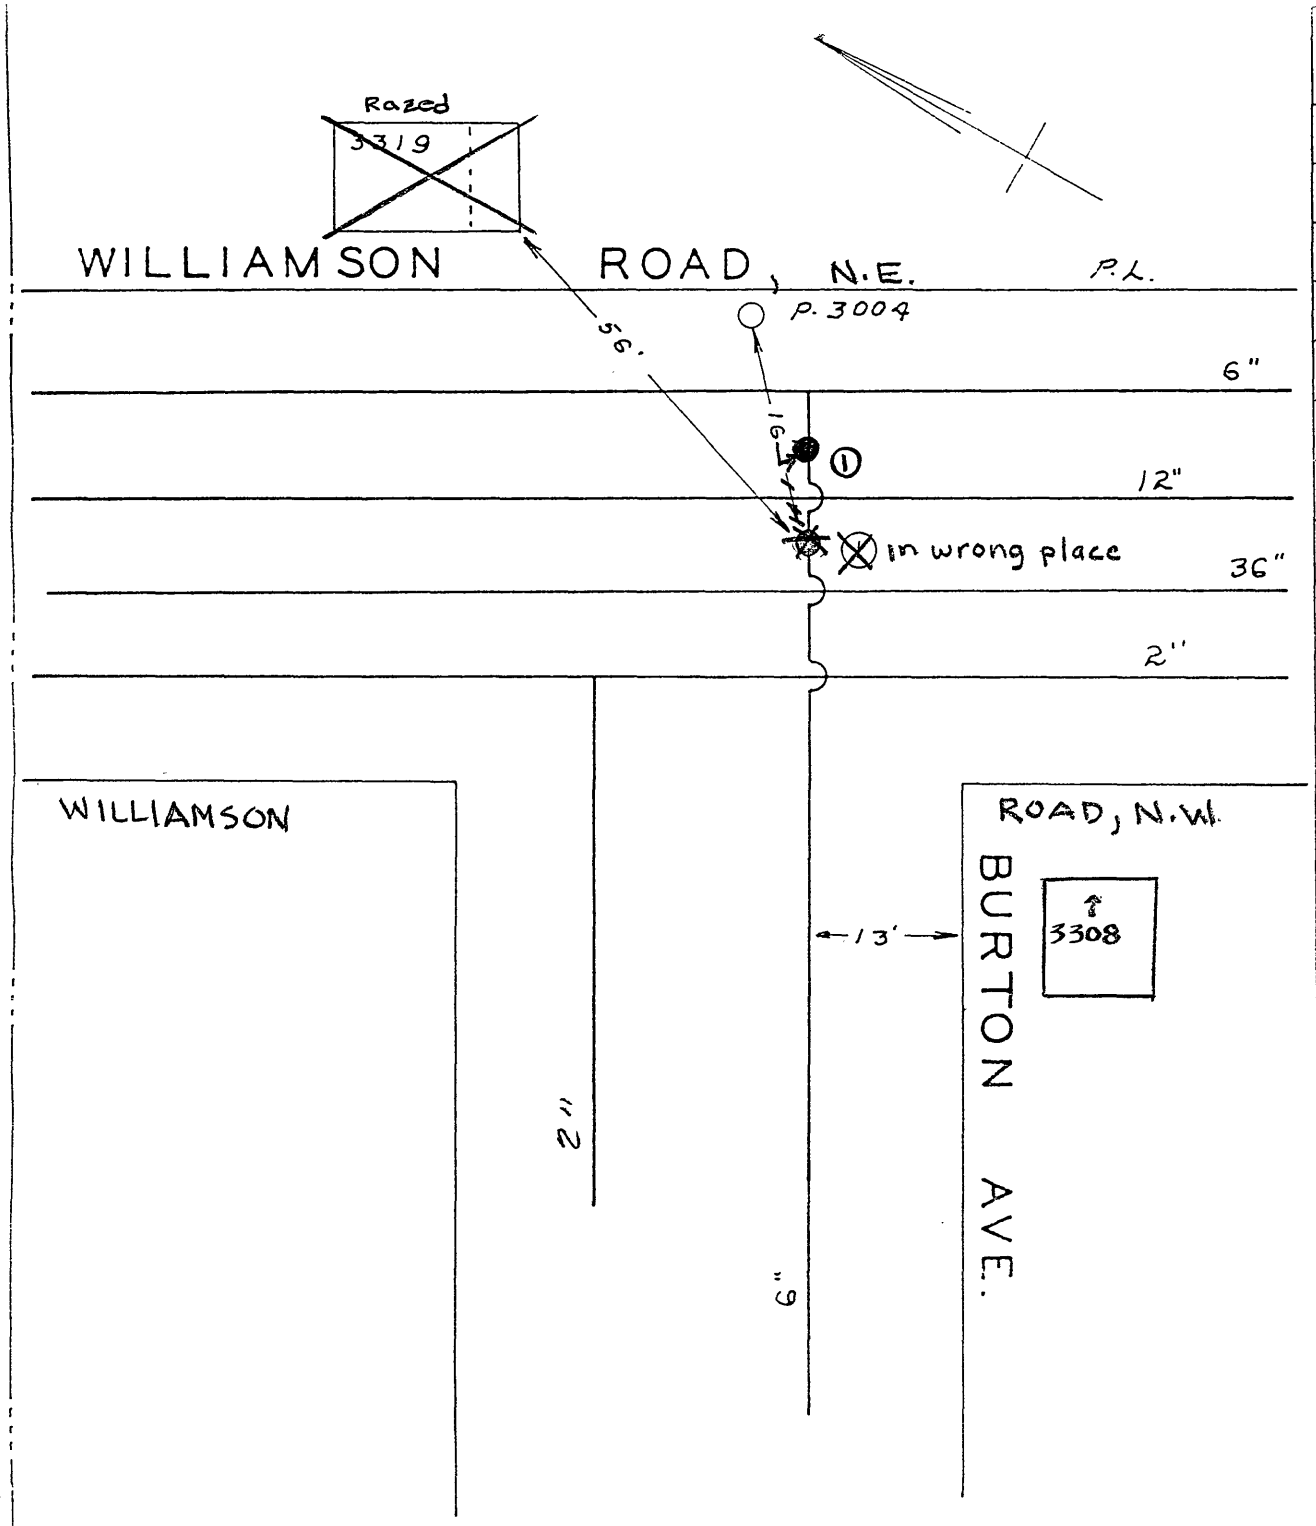

DATE	NO.	SIZE	MAKE	OPEN	TURNS
1951 W.R.	1	6"			
	1	18'-W	EPL		

CITY OF ROANOKE—WATER DEPT.

VALVE DIAGRAM

BURTON AVE. & WILLIAMSON ROAD N. W. OR N. E.

SEC. MAP

DATE PAGE NO.

"IMPERIAL" TRACING CLOTH K & E CO., N. Y.