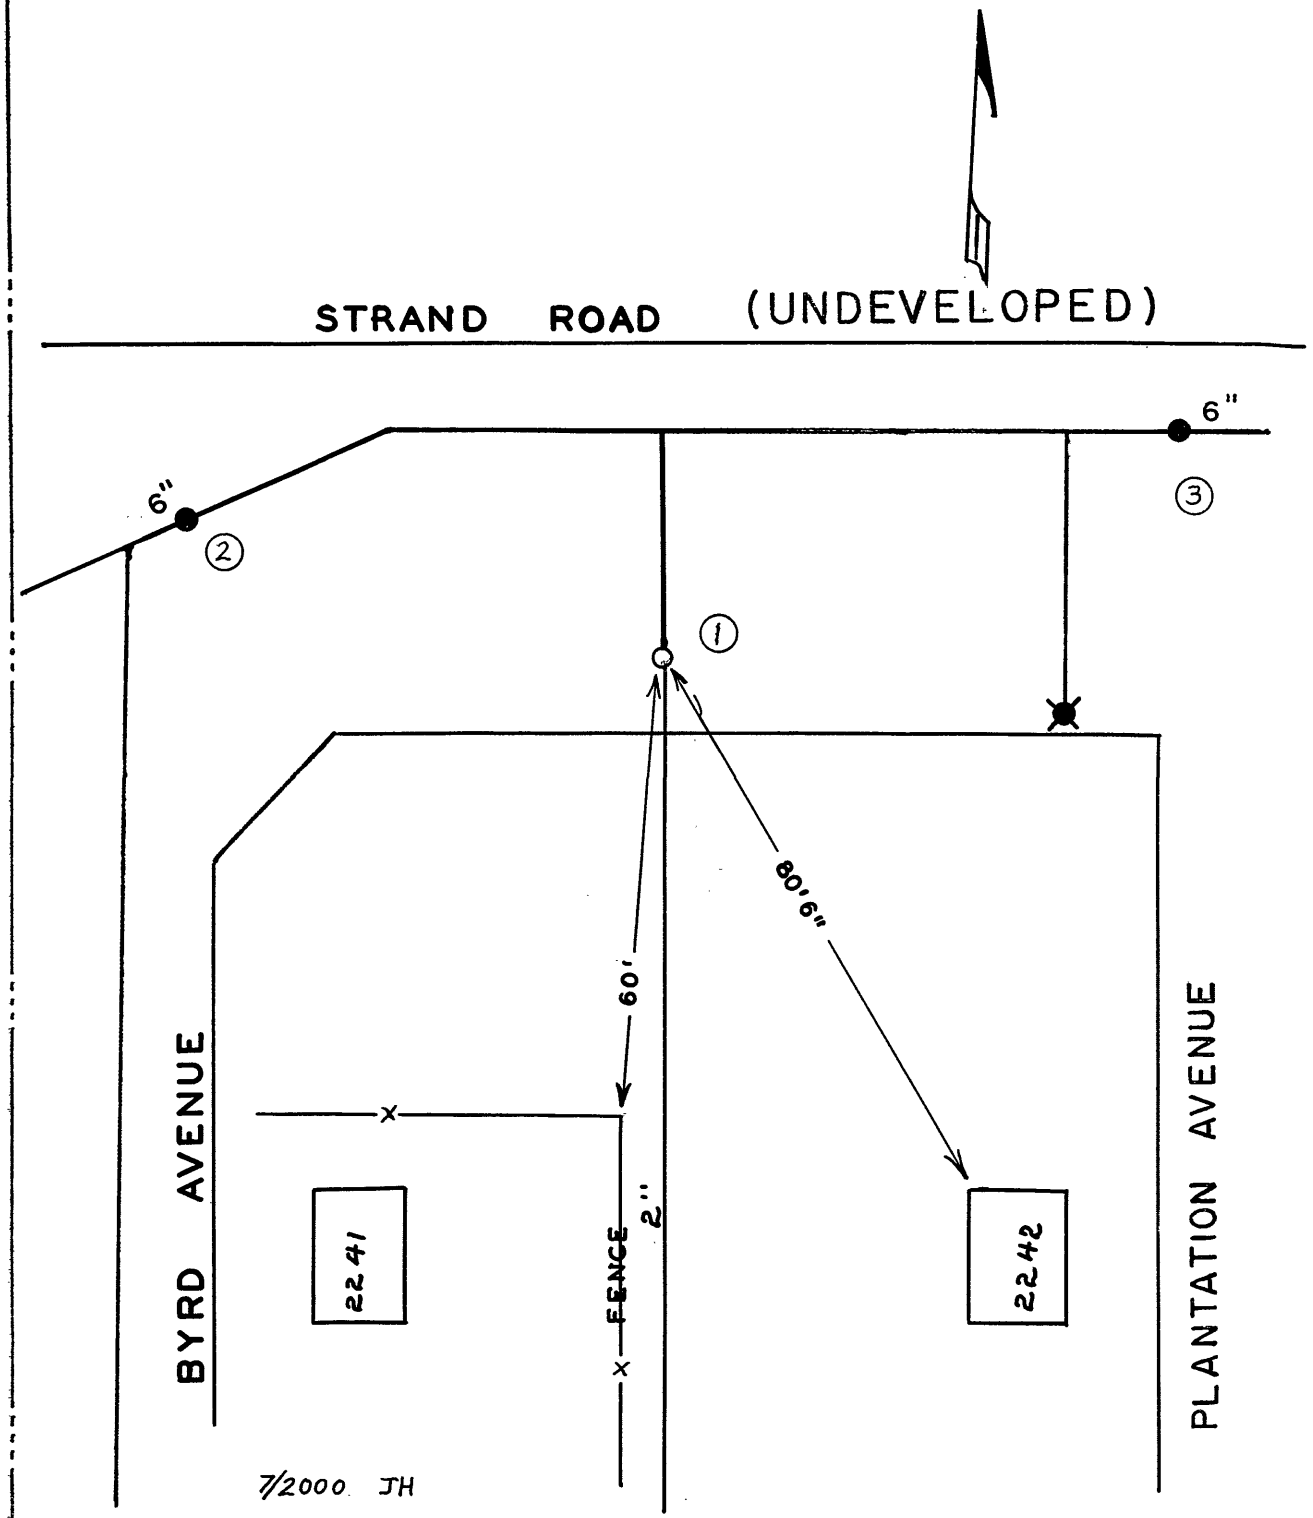

DATE	NO.	SIZE	MAKE	OPEN	TURNS
11-64	1	2	MISC.	L	8 3/4
1963	2	6	MUELLER	R	
1966	3	6	MUELLER	R	

CITY OF ROANOKE—WATER DEPT.
VALVE DIAGRAM
BYRD AVENUE
PLANTATION AVENUE
STRAND ROAD N.E.
SEC. MAP 312
DATE PAGE NO.