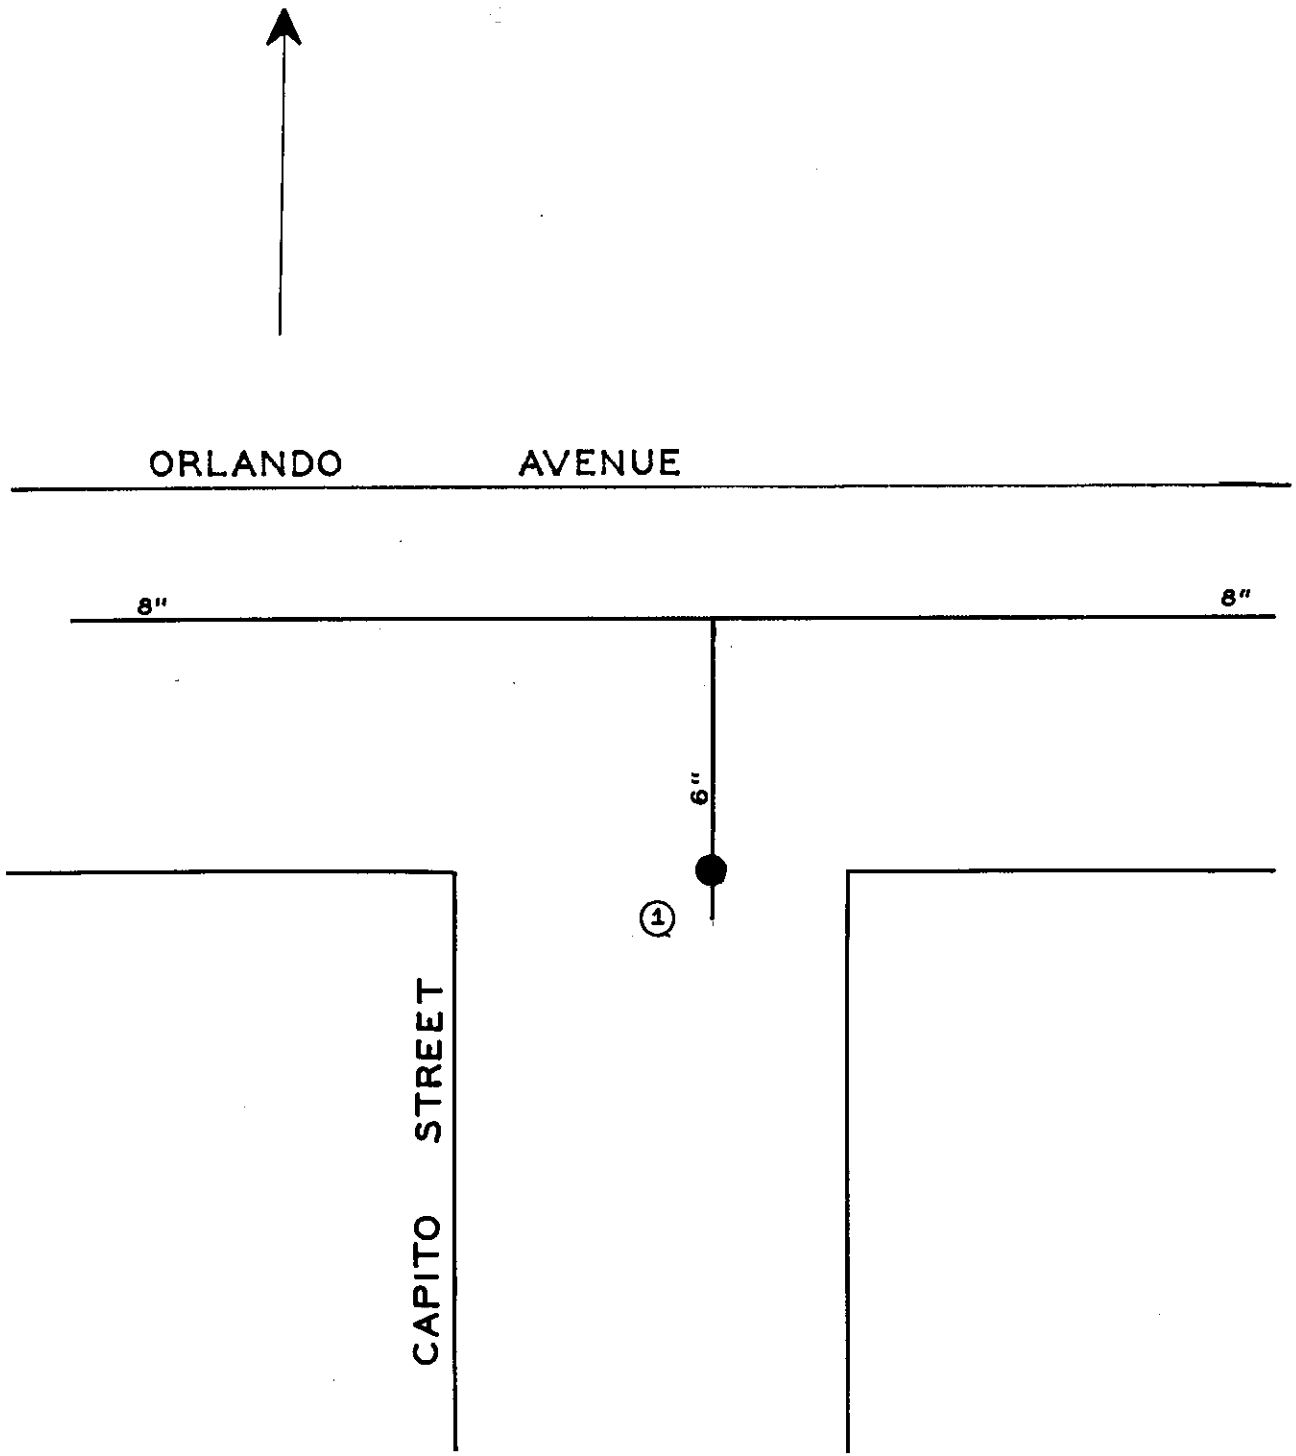

DATE	NO.	SIZE	MAKE	OPEN	TURNS
5-60	1	6"			

CITY OF ROANOKE — WATER DEPT.

VALVE DIAGRAM

CAPITO STREET &

ORLANDO AVENUE N.E.

SEC. MAP 32 Roanoke County

DATE PAGE NO.