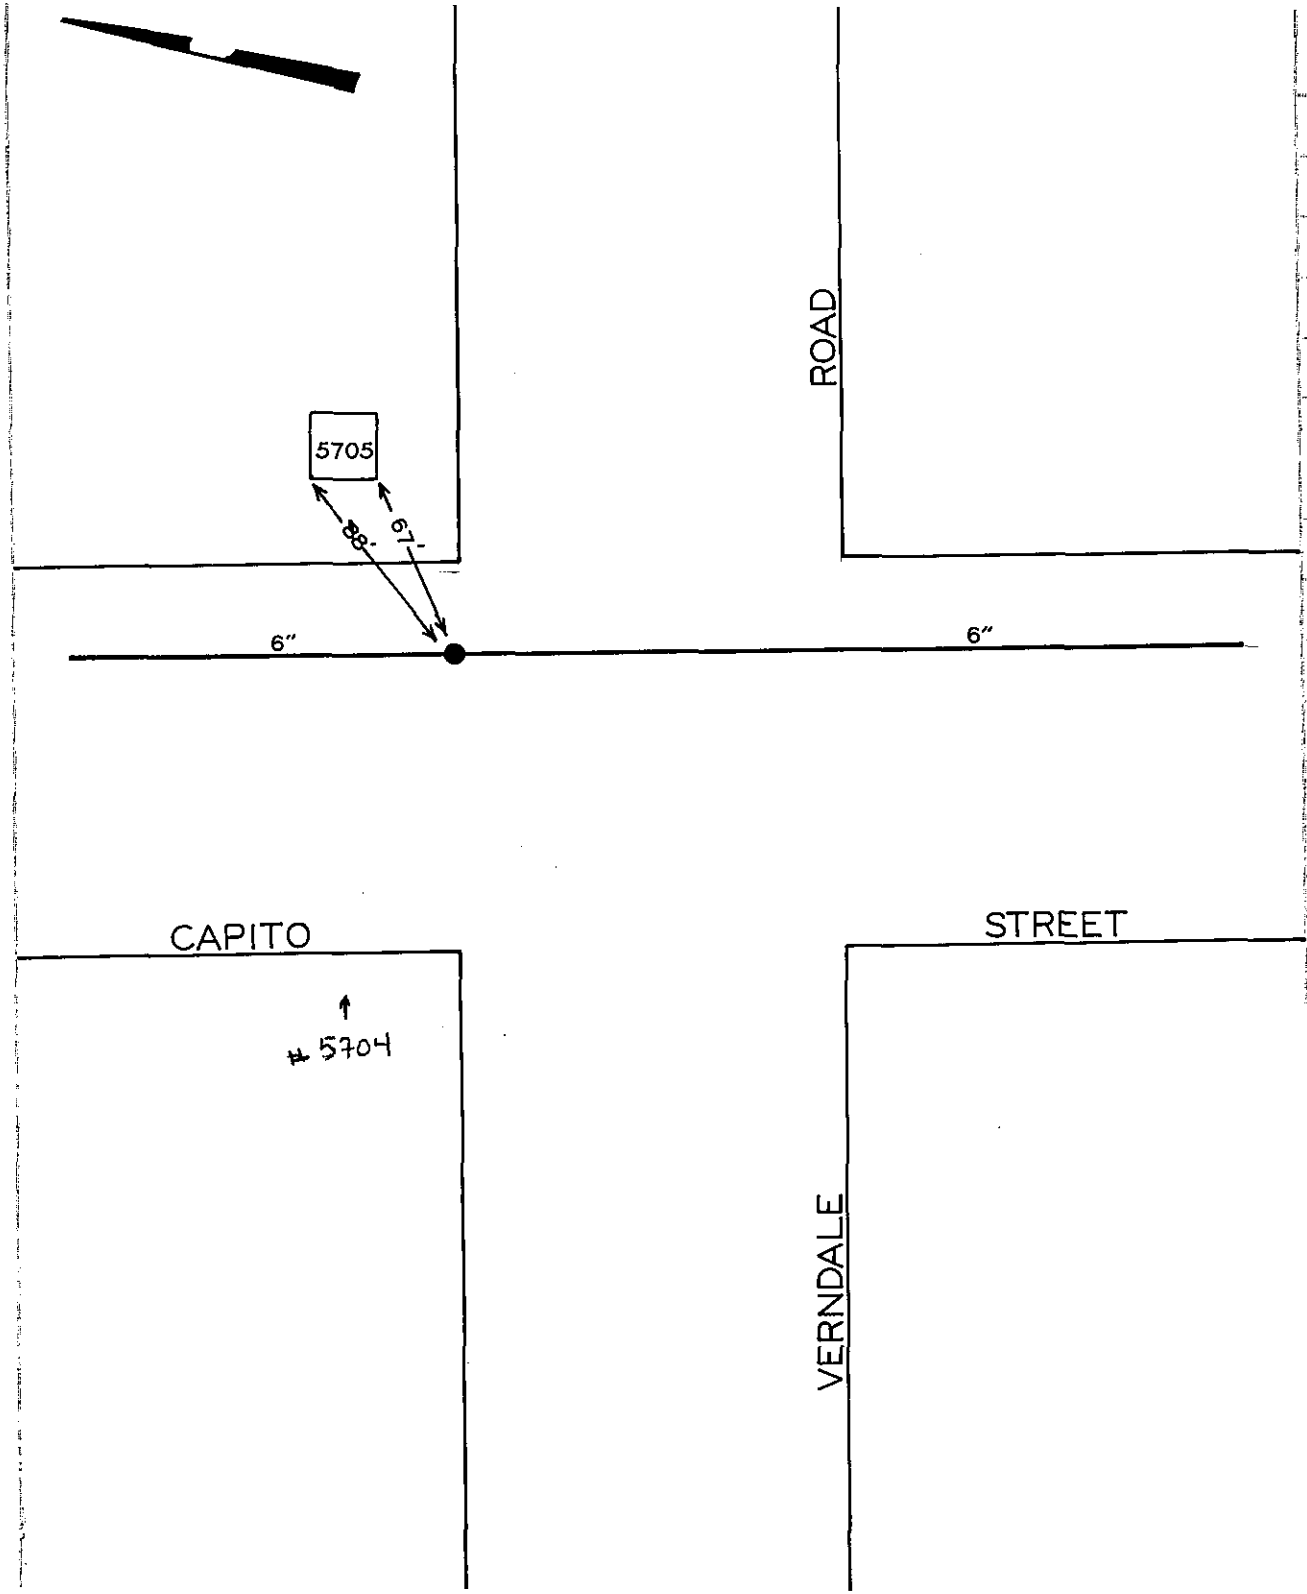


| DATE | NO. | SIZE | MAKE | OPEN | TURNS |
|---|---|---|---|---|---|
| 69 | 1 | 6" | MUELLER | R | 21 |

CITY OF ROANOKE – WATER DEPT

VALVE DIAGRAM

CAPITO STREET &

VERNDALE ROAD N.E.

SEC MAP 51 Roanoke County

DATE PAGE NO.