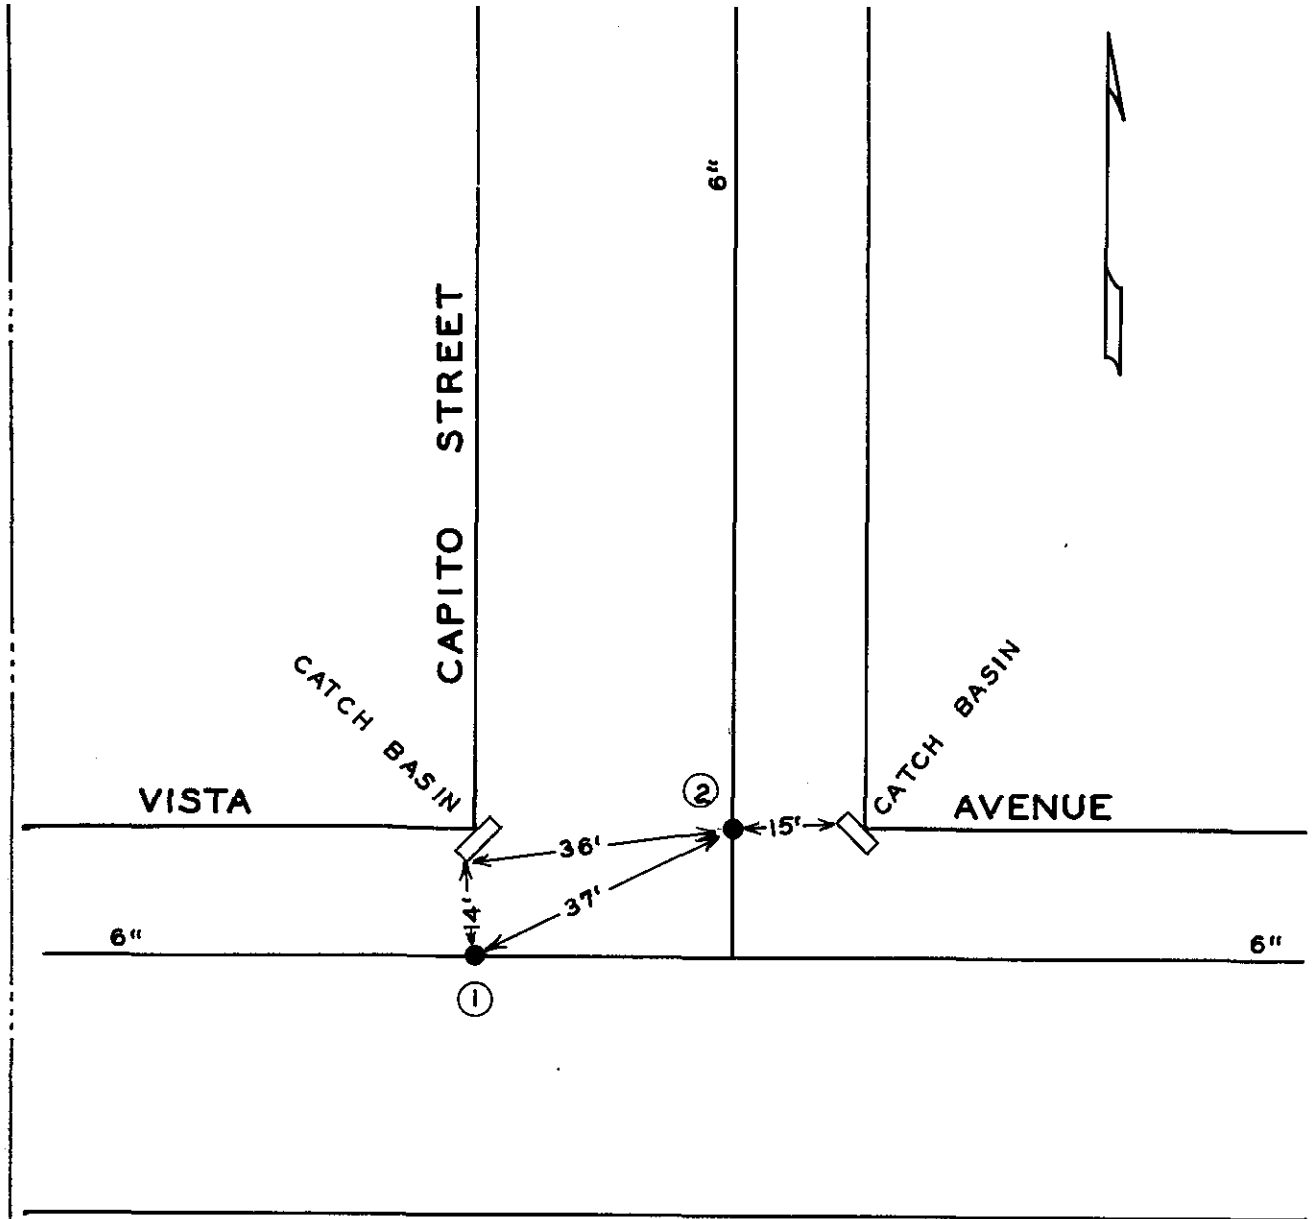

DATE	NO.	SIZE	MAKE	OPEN	TURNS
9-63	1	6	MUELLER	R	21
9-63	2	6"	MUELLER	R	21
	1	0	W.P.L.		
	2	0	N.P.L.		

CITY OF ROANOKE—WATER DEPT.

VALVE DIAGRAM

CAPITO STREET &

VISTA AVENUE N.E.

SEC. MAP 32 Roanoke County

DATE PAGE NO.