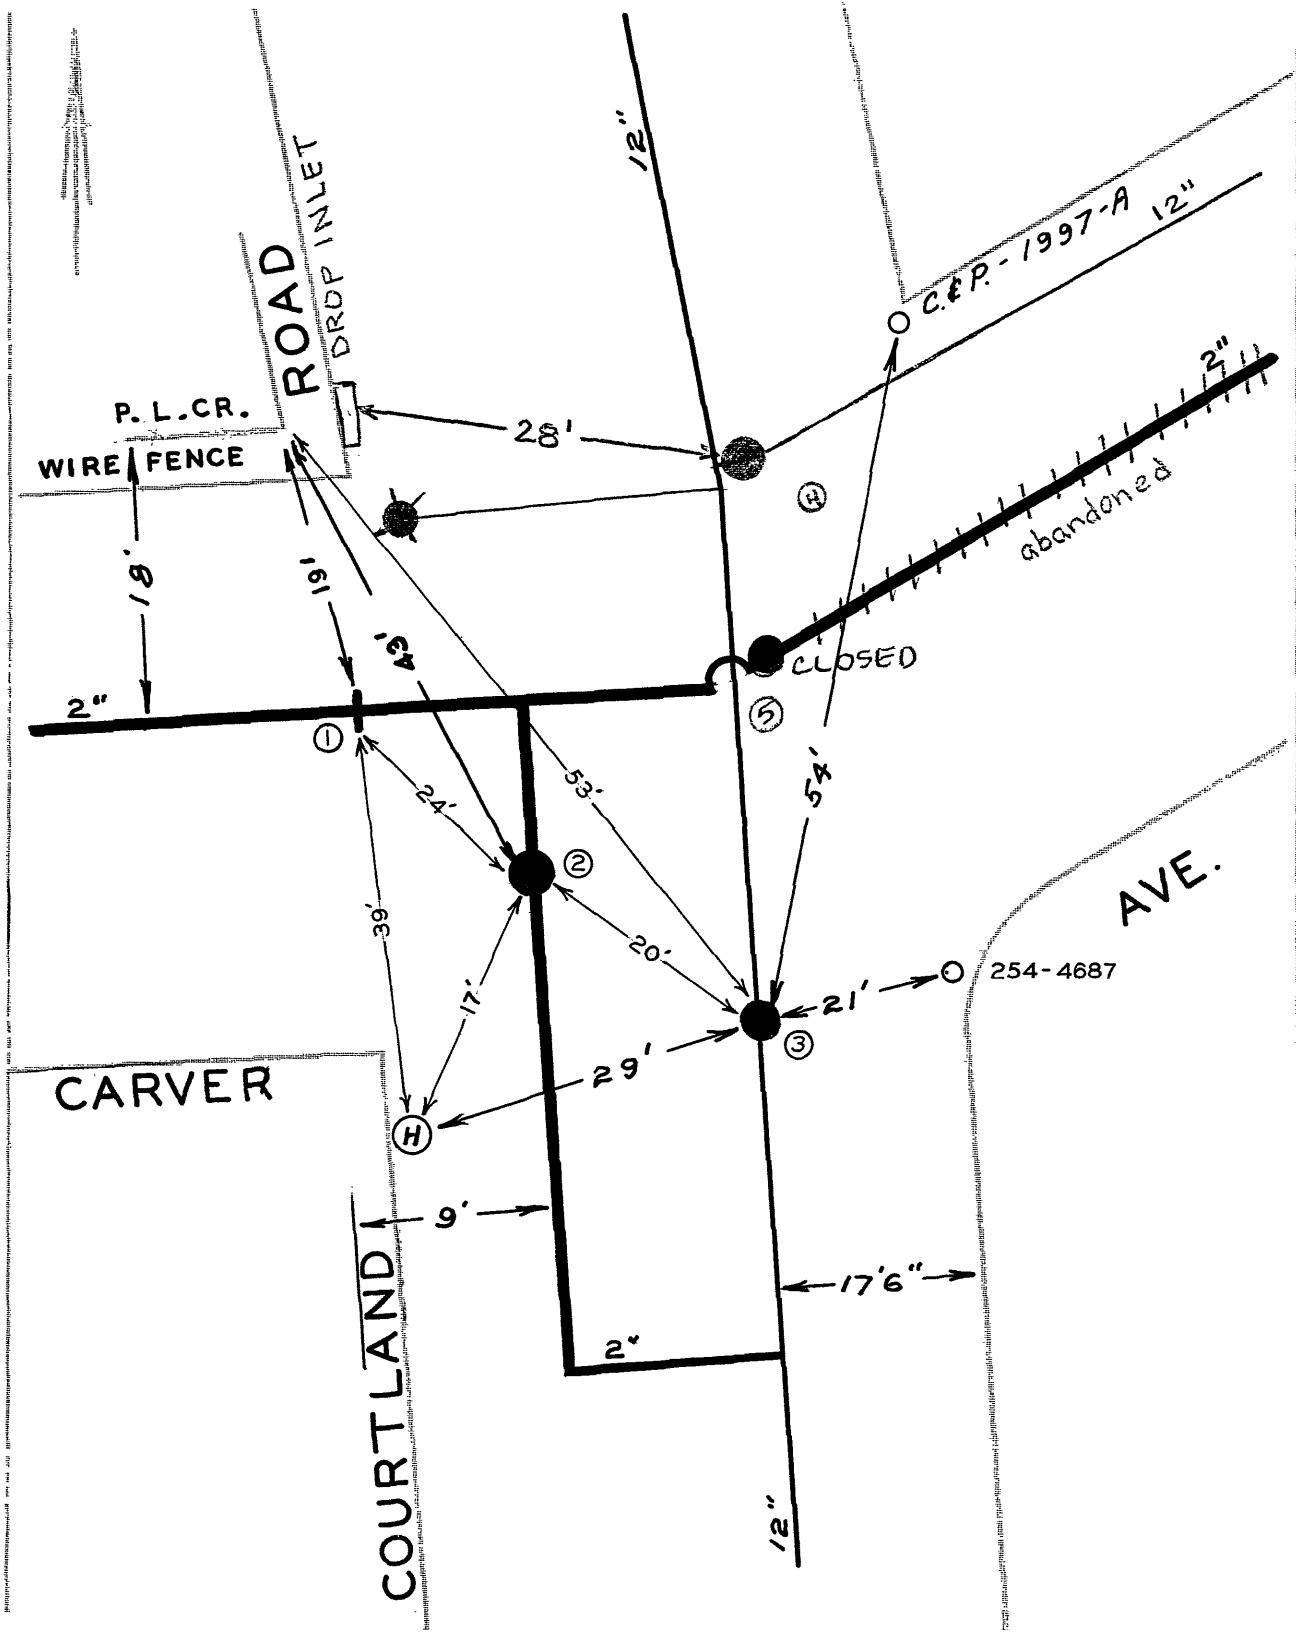

DATE	NO.	SIZE	MAKE	OPEN	TURNS
1924	1	2"		R	7
1932	2	2"		R	7
1957	3	12"	MUELLER	R	
1995	4	12"			
	5	2"			
	1	7'-E	WPL		
	2	0	SPL		
	3	0	SPL		

CITY OF ROANOKE—WATER DEP'T

VALVE DIAGRAM

CARVER AVENUE &

COURTLAND RD. N. E.

SEC. MAP 302

DATE

PAGE NO. NE 78