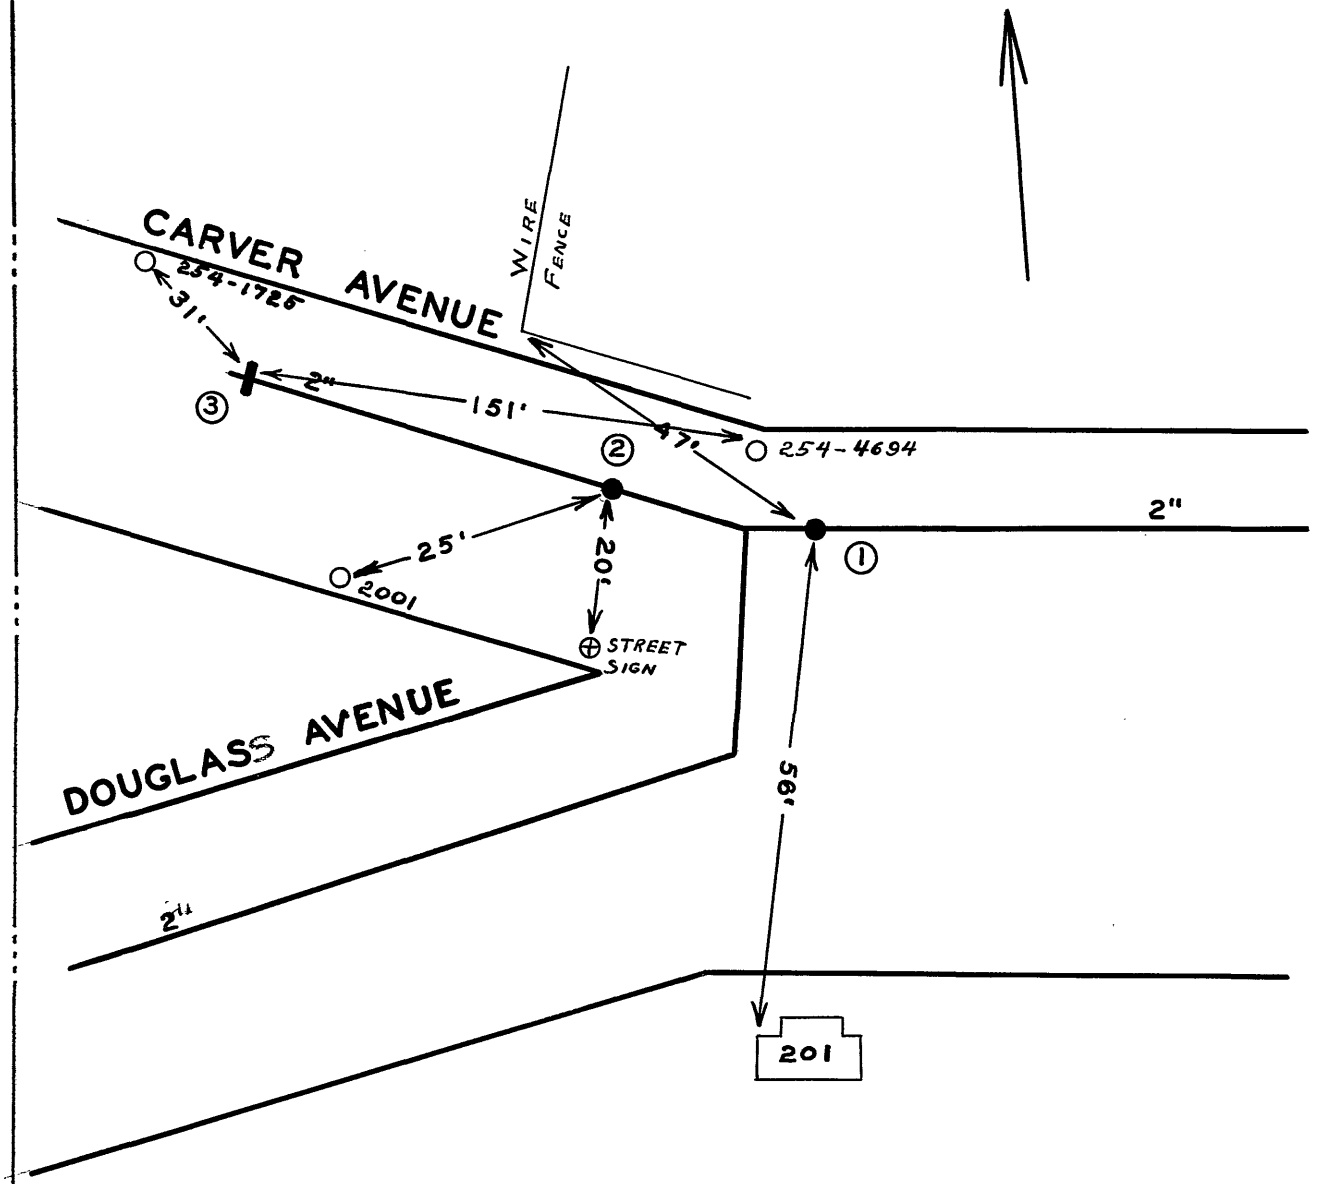

DATE	NO.	SIZE	MAKE	OPEN	TURNS
1924	1	2"		R	8
	2	2"	MISC.		
2-64	3	2"	MISC.	L	

CITY OF ROANOKE—WATER DEPT.

VALVE DIAGRAM

CARVER AVENUE &

DOUGLASS AVENUE N.E

SEC. MAP 307

DATE PAGE NO.