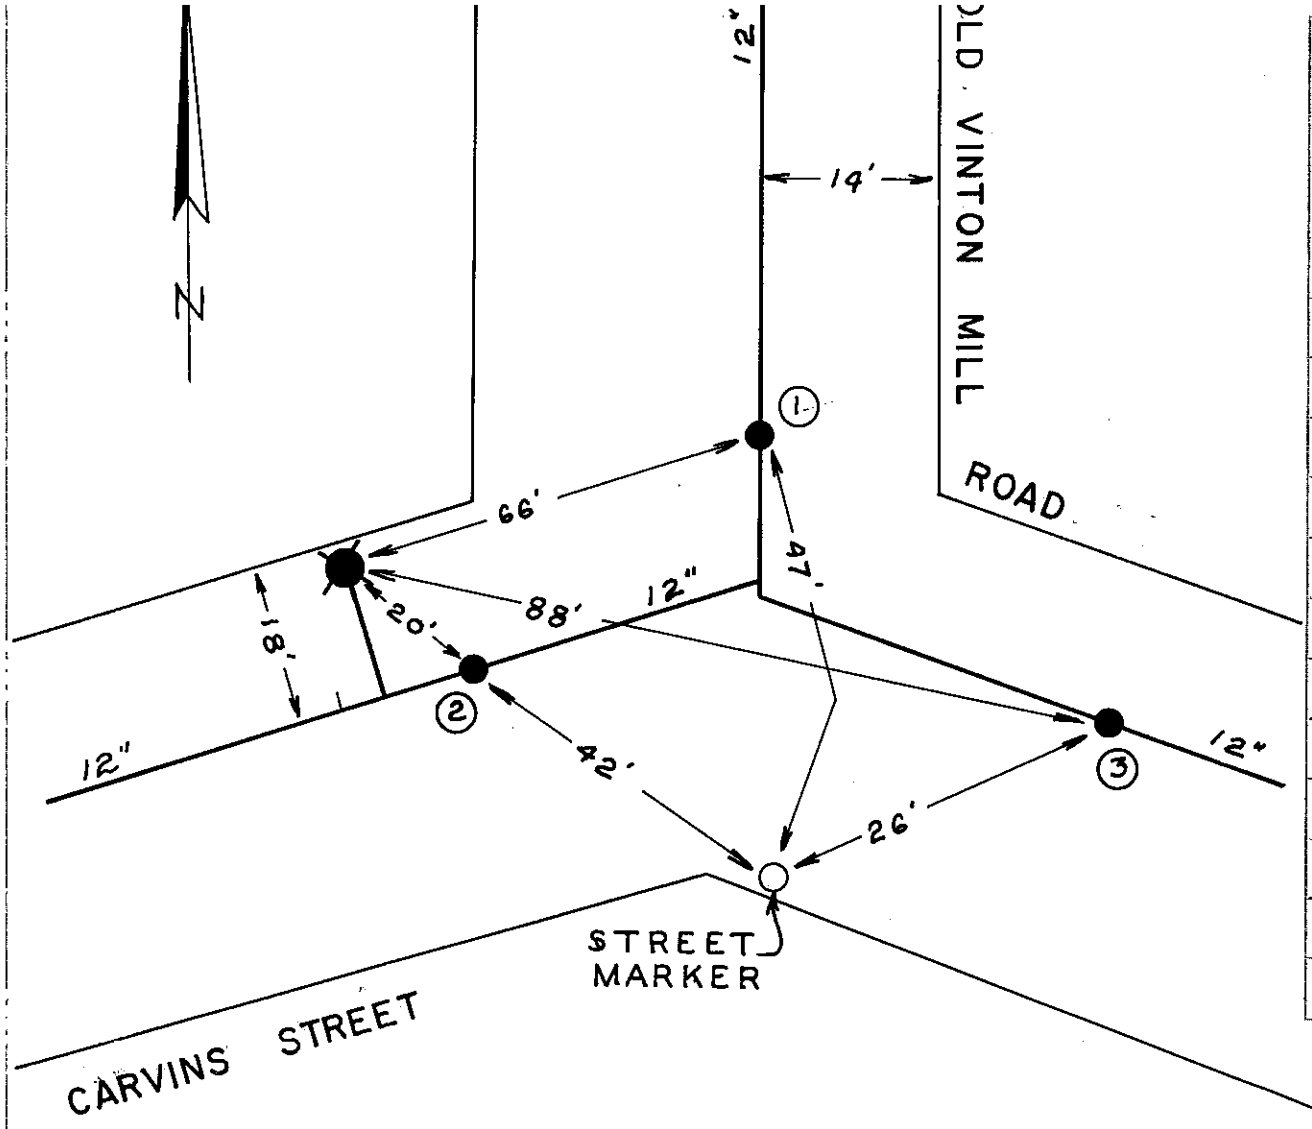

DATE	NO.	SIZE	MAKE	OPEN	TURNS
1952	1	12"	MUELLER	R	38
1952	2	12"	MUELLER	R	38
1952	3	12"	MUELLER	R	38
	1	0	NPL		
	2	0	WPL		
	3	0	SPL		

CITY OF ROANOKE — WATER DEPT.

VALVE DIAGRAM

CARVIN STREET &

OLD VINTON MILL ROAD

SEC. MAP 333, 332 N.E.

DATE PAGE NO.

9/2000 JH