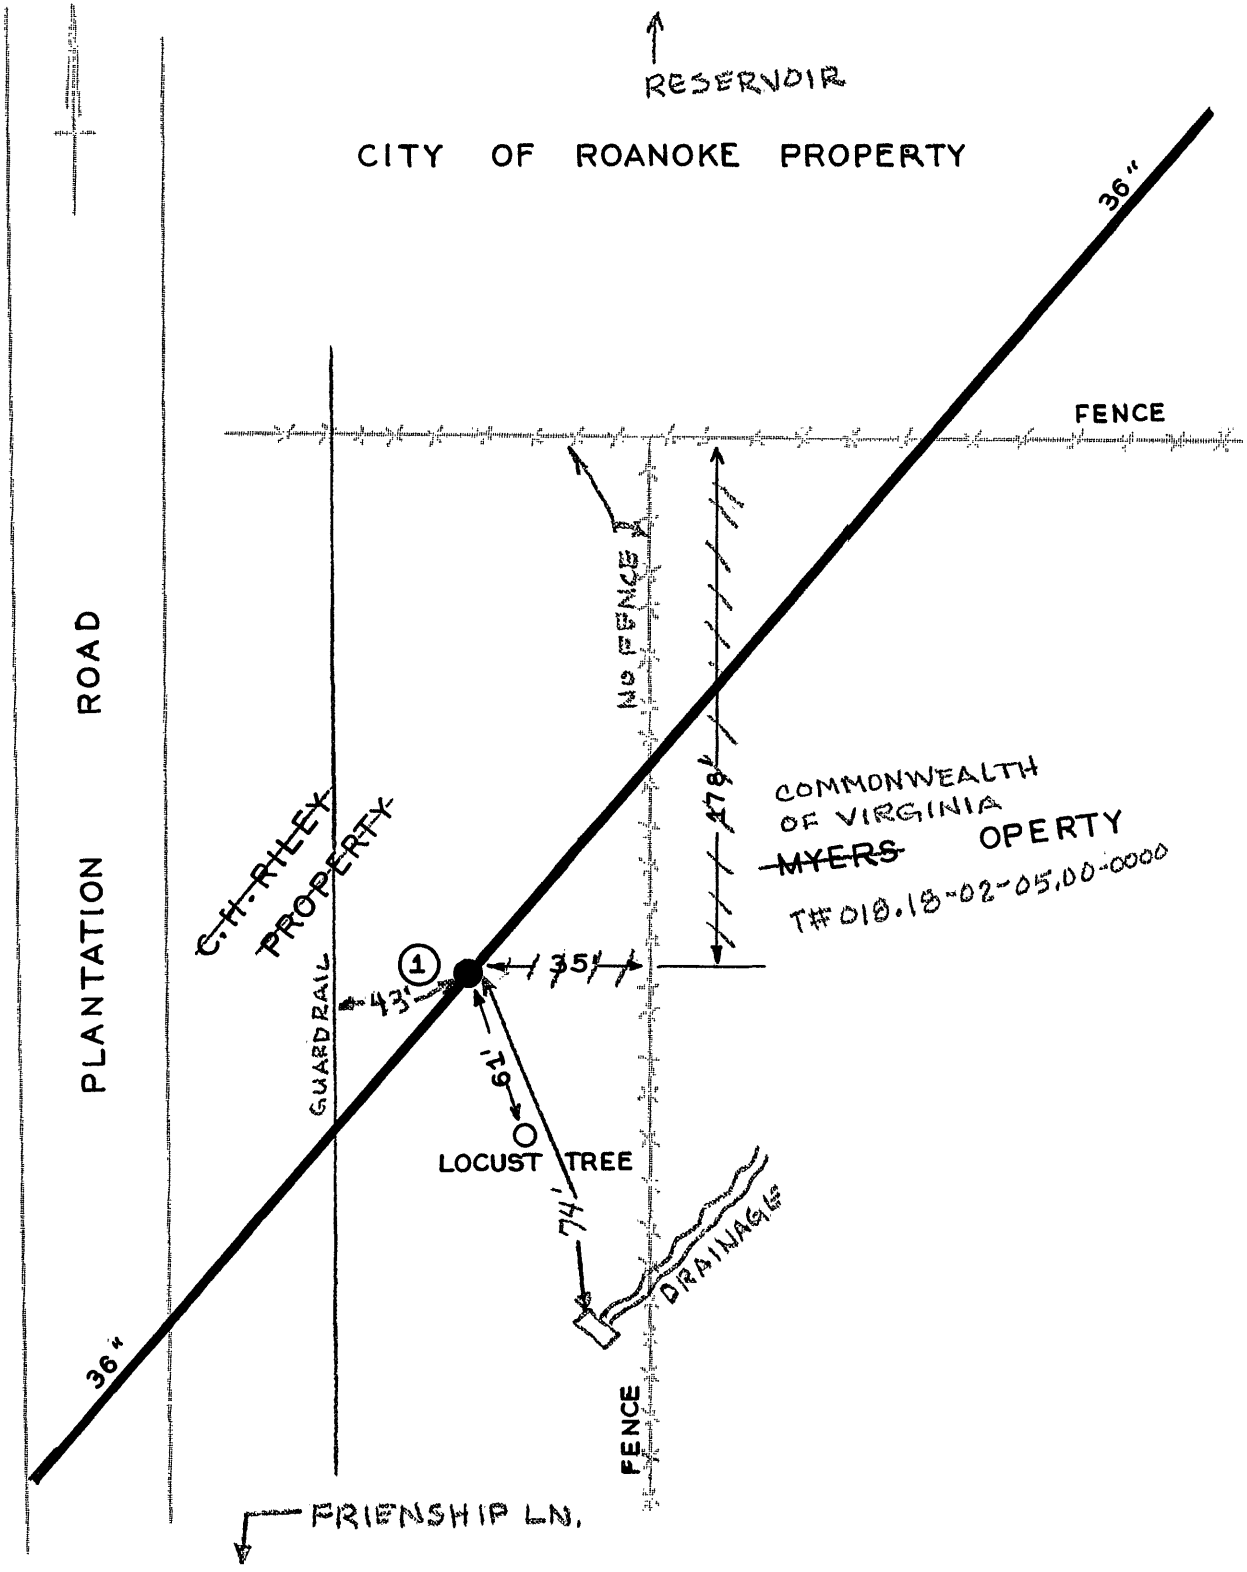

DATE	NO.	SIZE	MAKE	OPEN	TURNS
1946	1	1	SIMPLEX AIR VALVE		

CITY OF ROANOKE—WATER DEPT

VALVE DIAGRAM

CARVINS COVE BETWEEN RESERVOIR & PLANTATION ROAD - NEAR FREINDSHIP LN.

SEC. MAP 21

DATE

PAGE NO. NE136