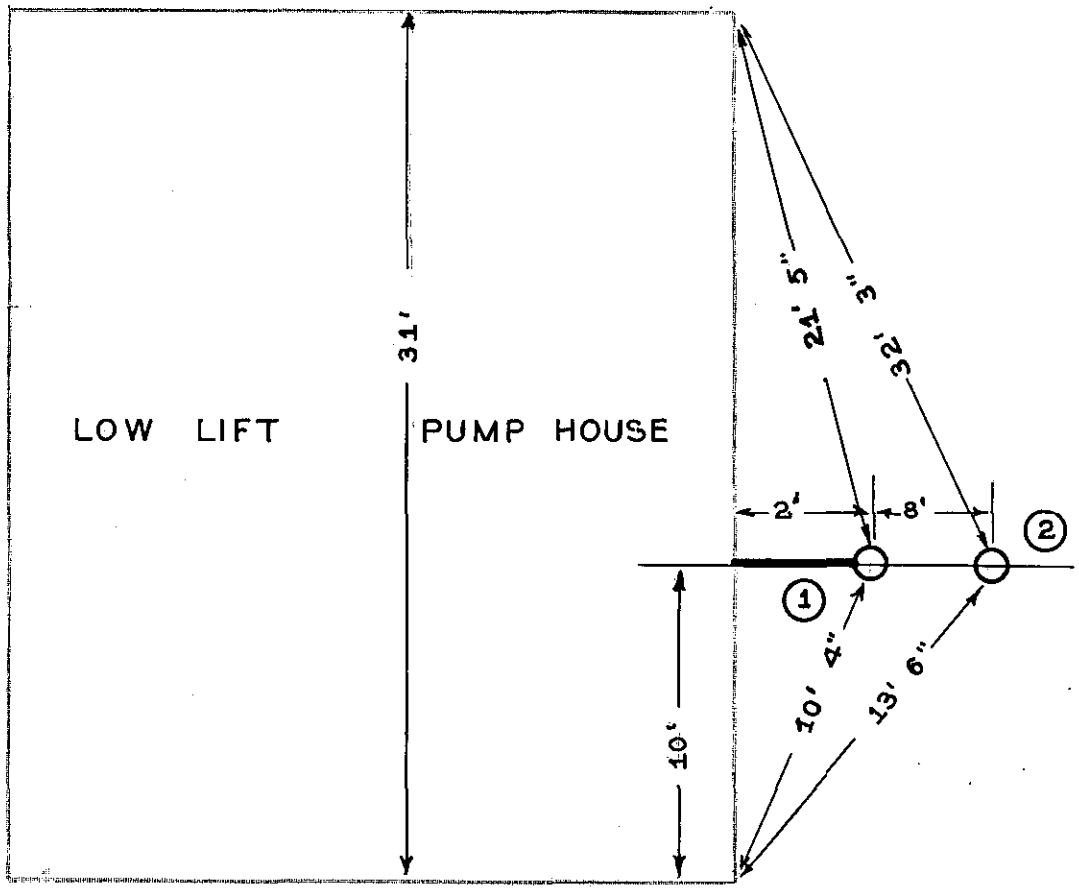

DATE	NO.	SIZE	MAKE	OPEN	TURNS
1946	1	30"	M. & H.	L	125
	2	4"	BY PASS	L	9

CITY OF ROANOKE—WATER DEP'T

VALVE DIAGRAM

CARVINS COVE FILTER PLANT LOW LIFT PUMP HOUSE

SEC. MAP 23

DATE

PAGE NO. NE140