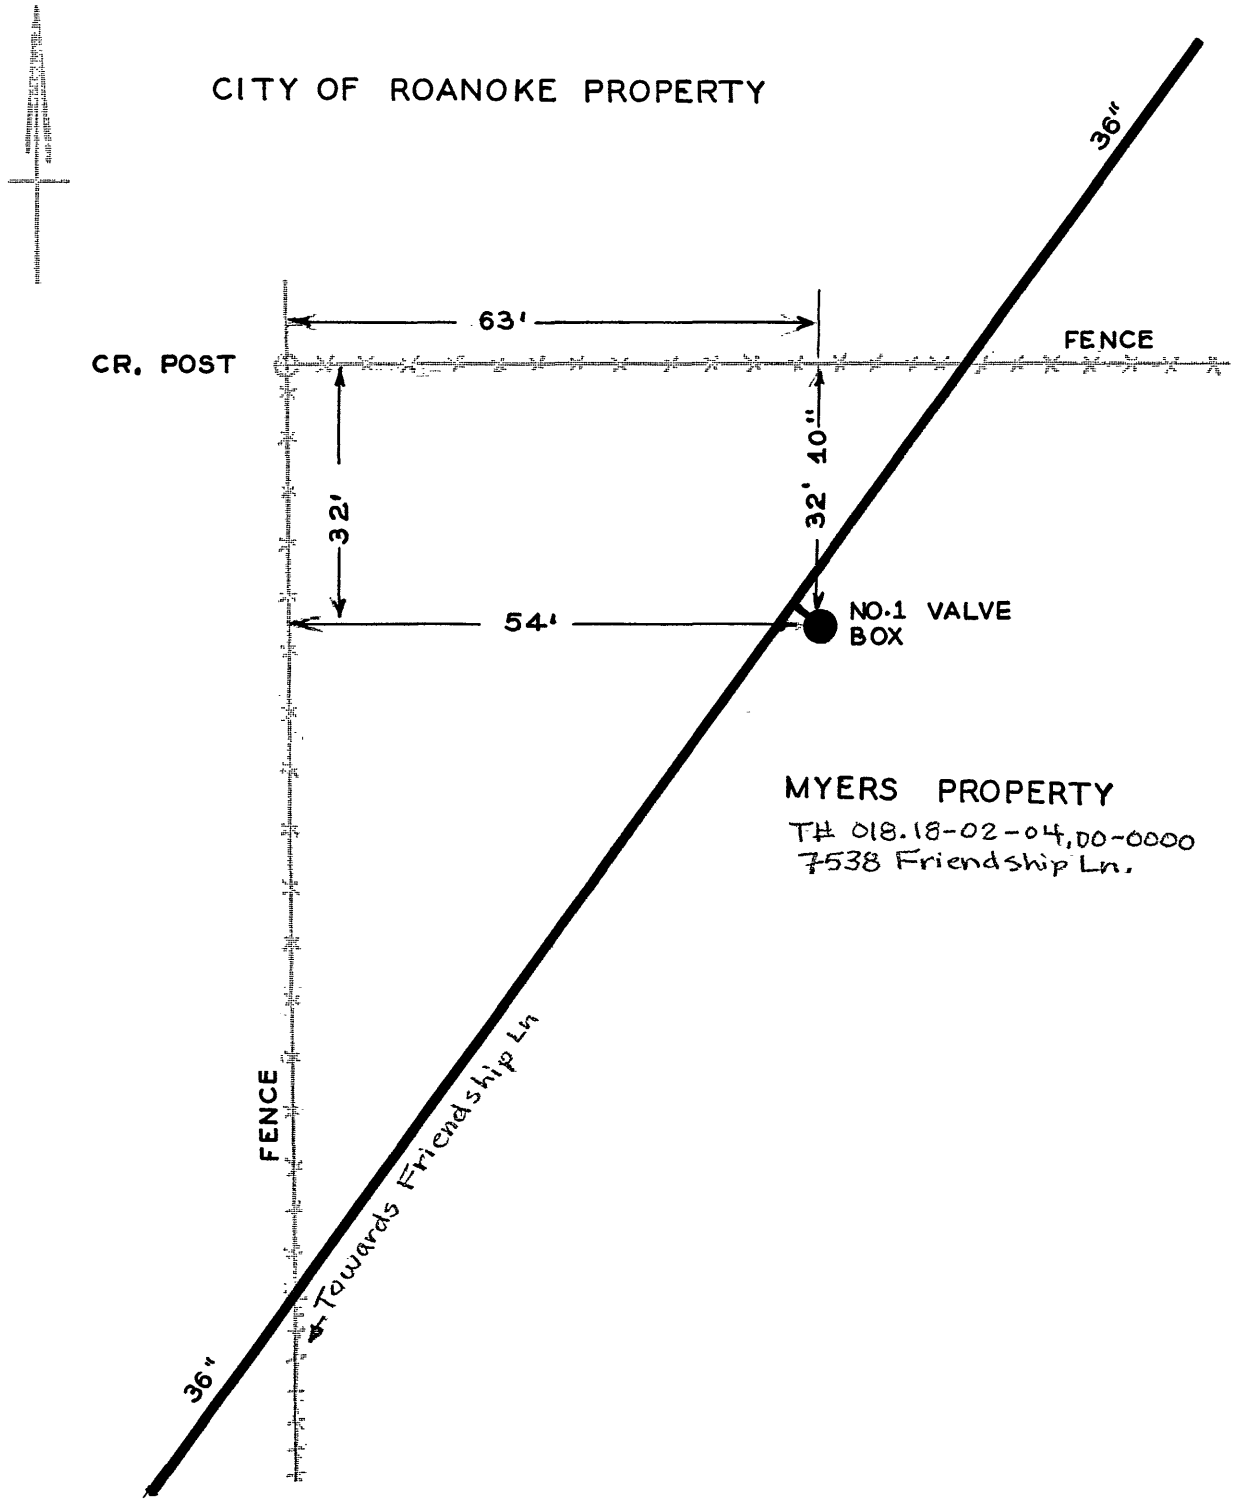

DATE	NO.	SIZE	MAKE	OPEN	TURNS
1946	1	8"	M. & H.	L	18

CITY OF ROANOKE—WATER DEP'T

VALVE DIAGRAM

CARVINS COVE SOUTH OF RESERVOIR ON MYERS PROPERTY

SEC. MAP 23 Roanoke County

DATE PAGE NO. NE137