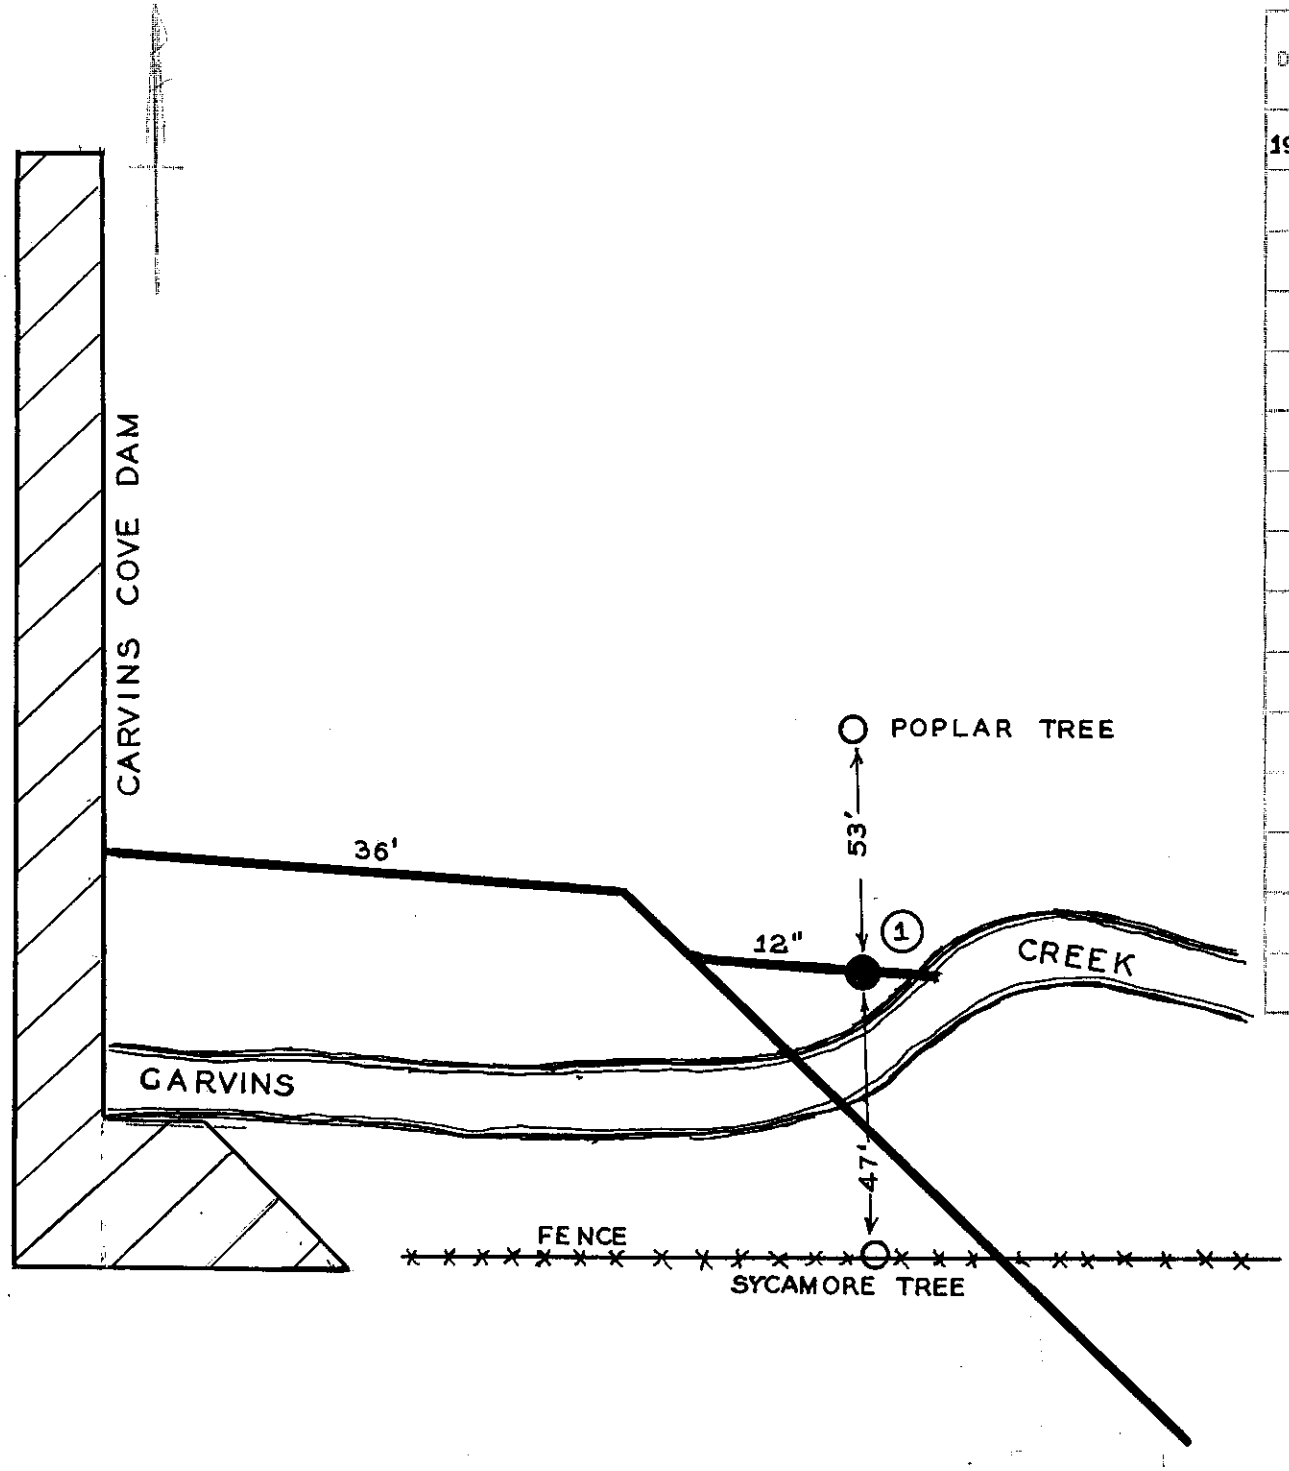

DATE	NO	SIZE	MAKE	OPEN	TURNS
1946	1	12"	BLOW OFF M & H	L	26

CITY OF ROANOKE — WATER DEP'T

VALVE DIAGRAM

CARVINS CREEK 975' E.
OF CARVINS COVE DAM

SEC. MAP 23

DATE

PAGE NO. NE 141