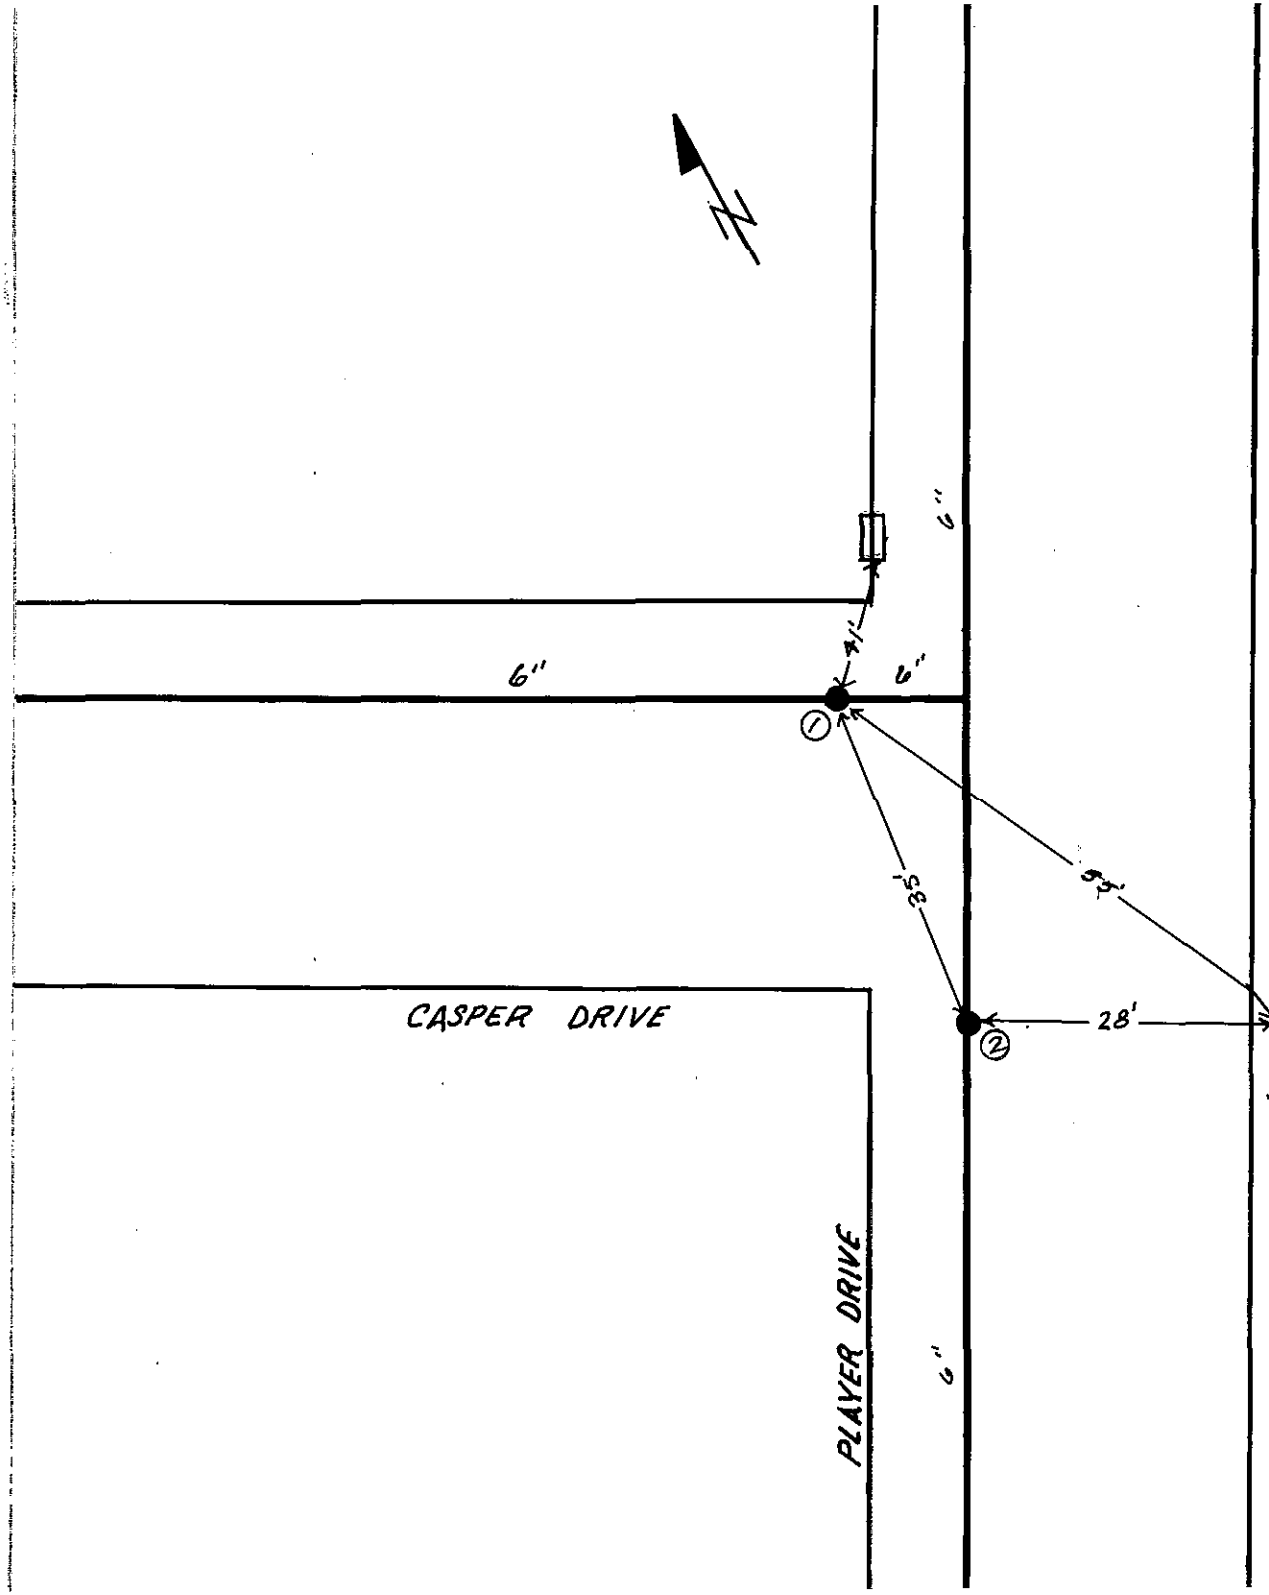

DATE	NO.	SIZE	MADE	OPEN	TURNS
1973	1	6"			
1973	2	6"			

CITY OF ROANOKE - WATER DEPT

VALVE DIAGRAM

CASPER DRIVE AND

PLAYER DRIVE N.E.

SEQ. MAP 737

DATE JULY 3, 1980 PAGE NO