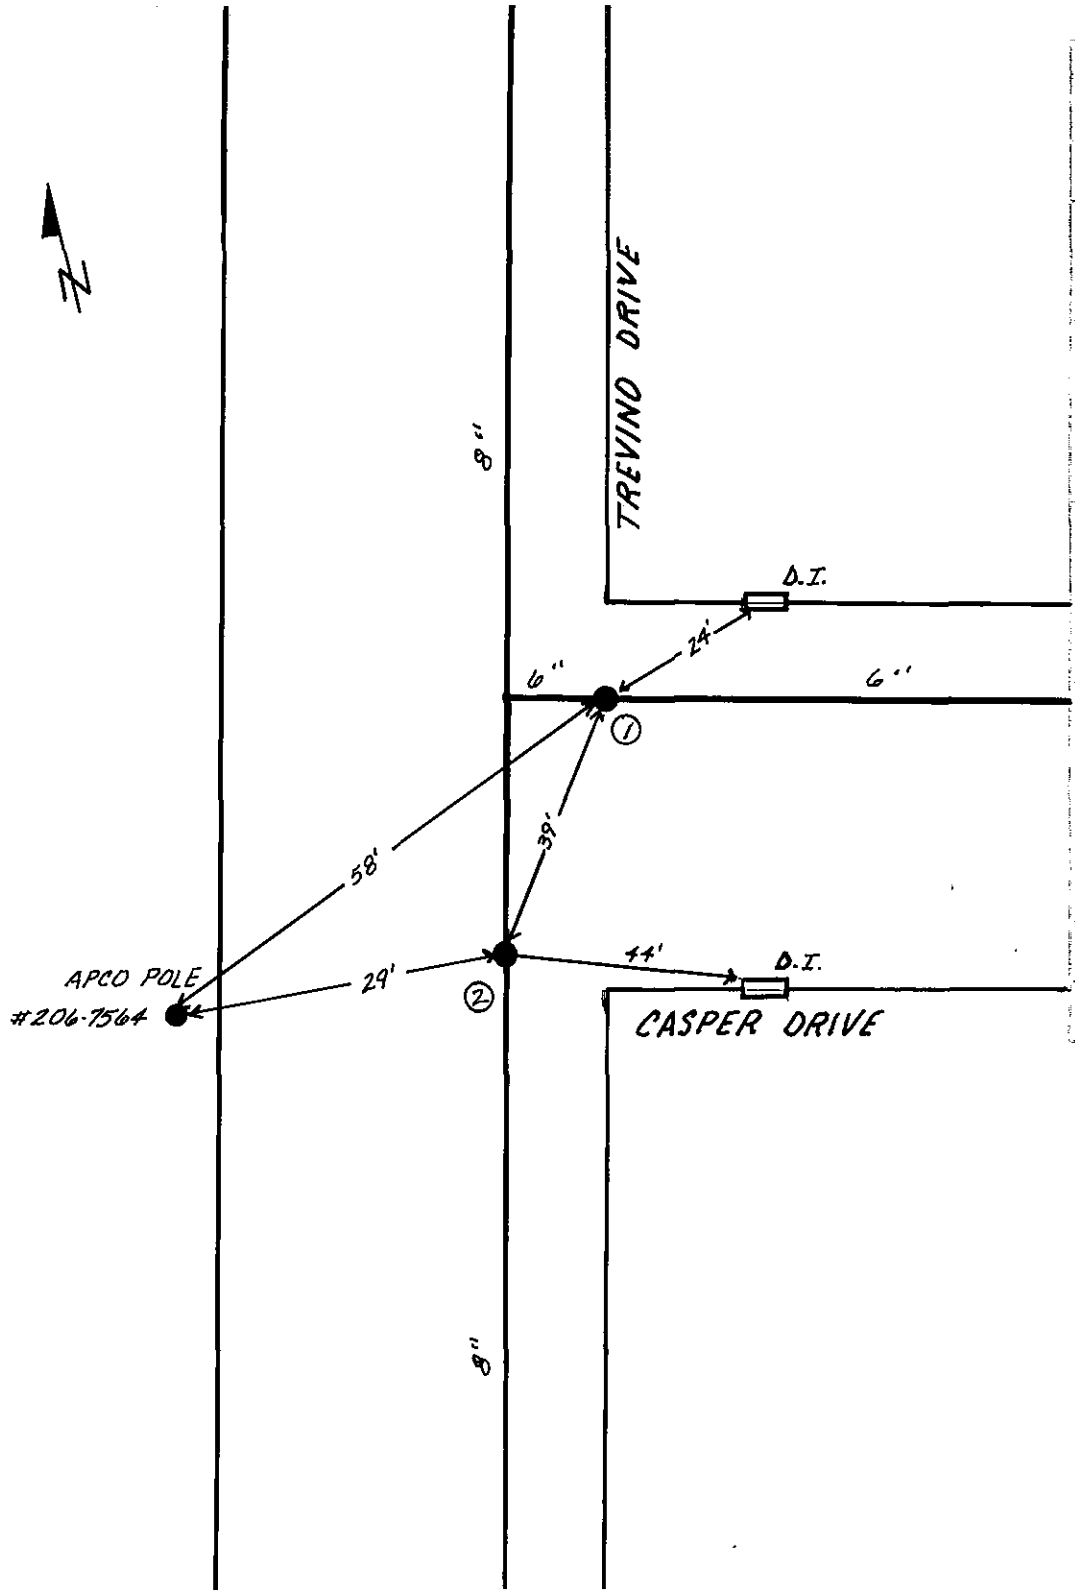

DATE	NO	SIZE	DESCR	OPEN	TURNS
1973	1	6"			
1973	2	8"			

VALVE DIAGRAM

CASPER DRIVE AND
TREVINO DRIVE N.E.

DWG NO. 737

DATE JULY 3, 1980 PAGE NO