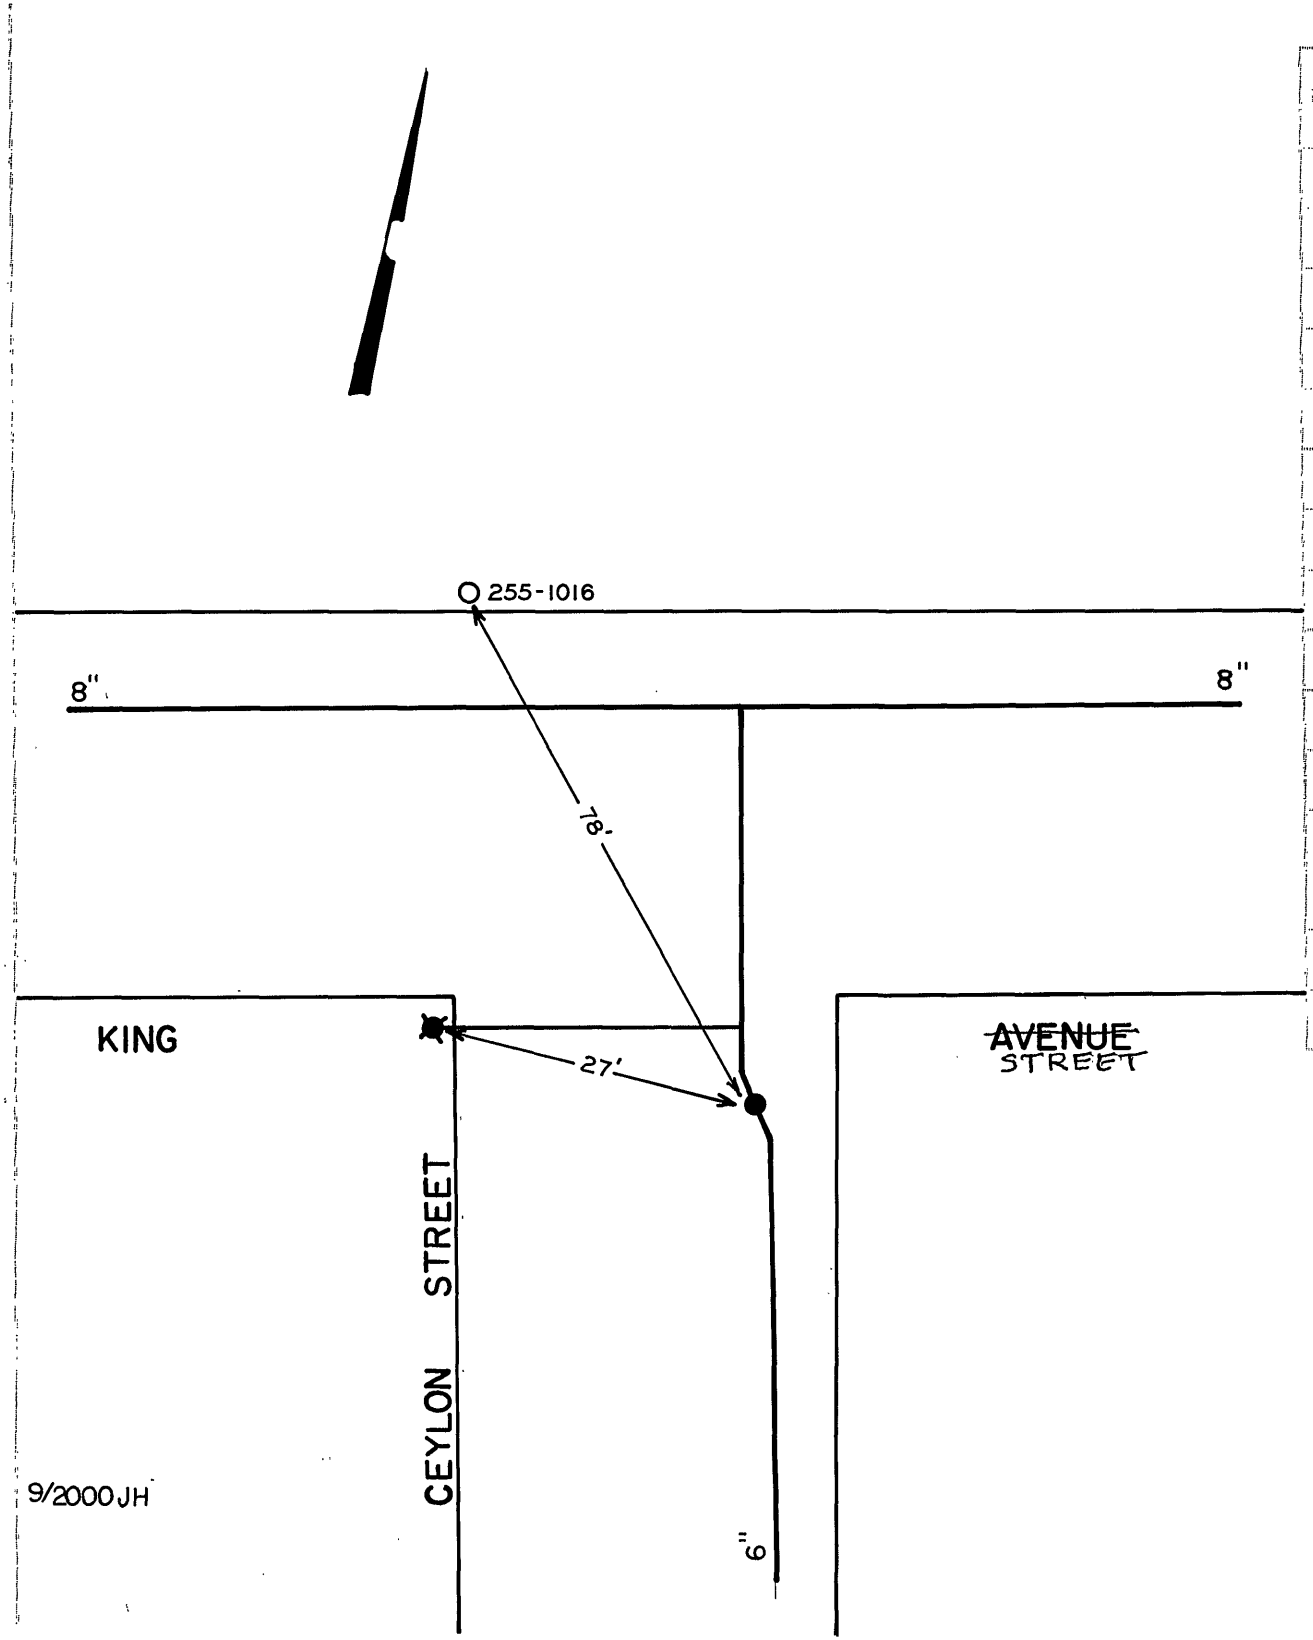

DATE	NO.	SIZE	MAKE	OPEN	TURNS
71	1	6"	DARLING	R	20
	1	24'-	S OF S.P.L.		


VALVE DIAGRAM

CEYLON STREET &

KING ~~AVENUE~~ STREET

SER. MAP 341 N.E.

DATE PAGE NO.