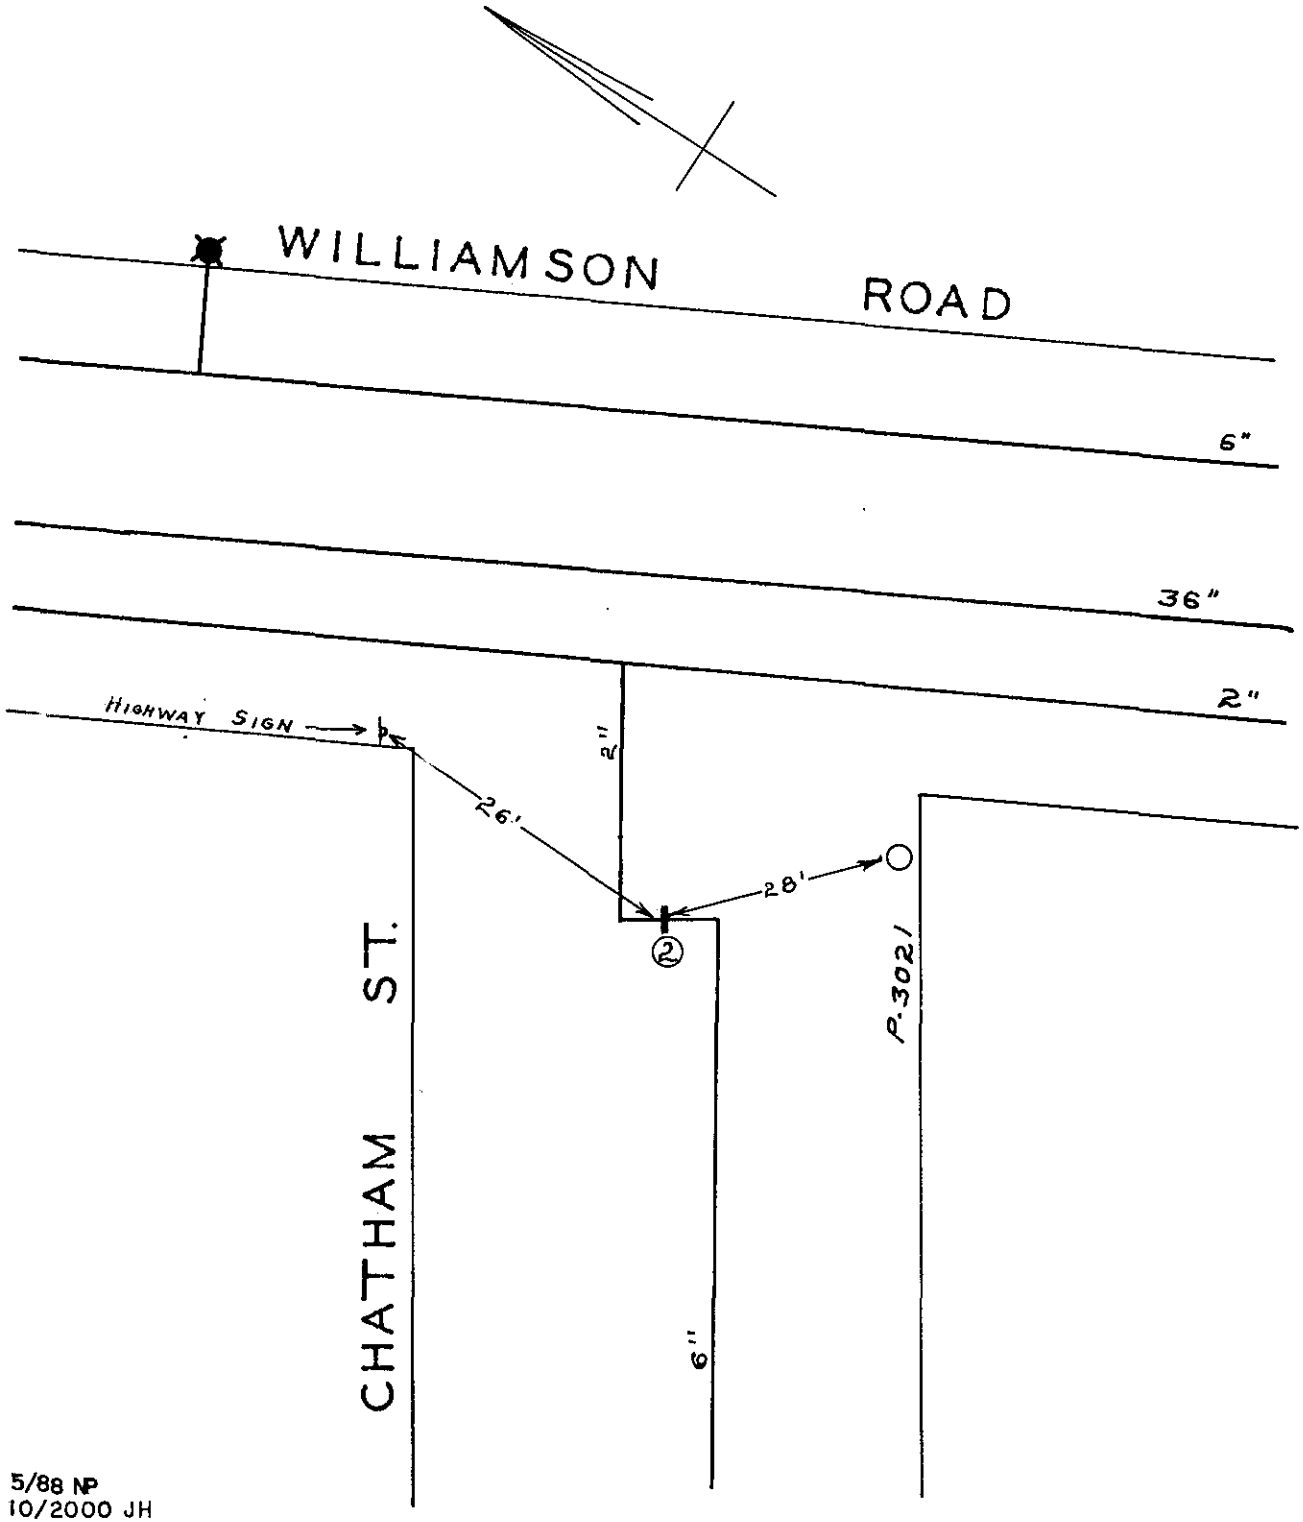


| DATE | NO | SIZE | MAKE | OPEN | TURNS |
|---|---|---|---|---|---|
| | | | | | |
| 1960 | 2 | 2" | DARLING | R | |
| | | | | | |
| | | | | | |
| | | | | | |
| | | | | | |
| | | | | | |
| | | | | | |
| | | | | | |
| | | | | | |
| | | | | | |
| | 1 | 7'-W | WPL | | |
| | | | | | |
| | | | | | |

CITY OF ROANOKE - WATER DEPT.

VALVE DIAGRAM

CHATHAM ST. & WILLIAMSON ROAD N.W. OR N.E.

SEC. MAP 207, 310

DATE PAGE NO.

5/88 NP
10/2000 JH