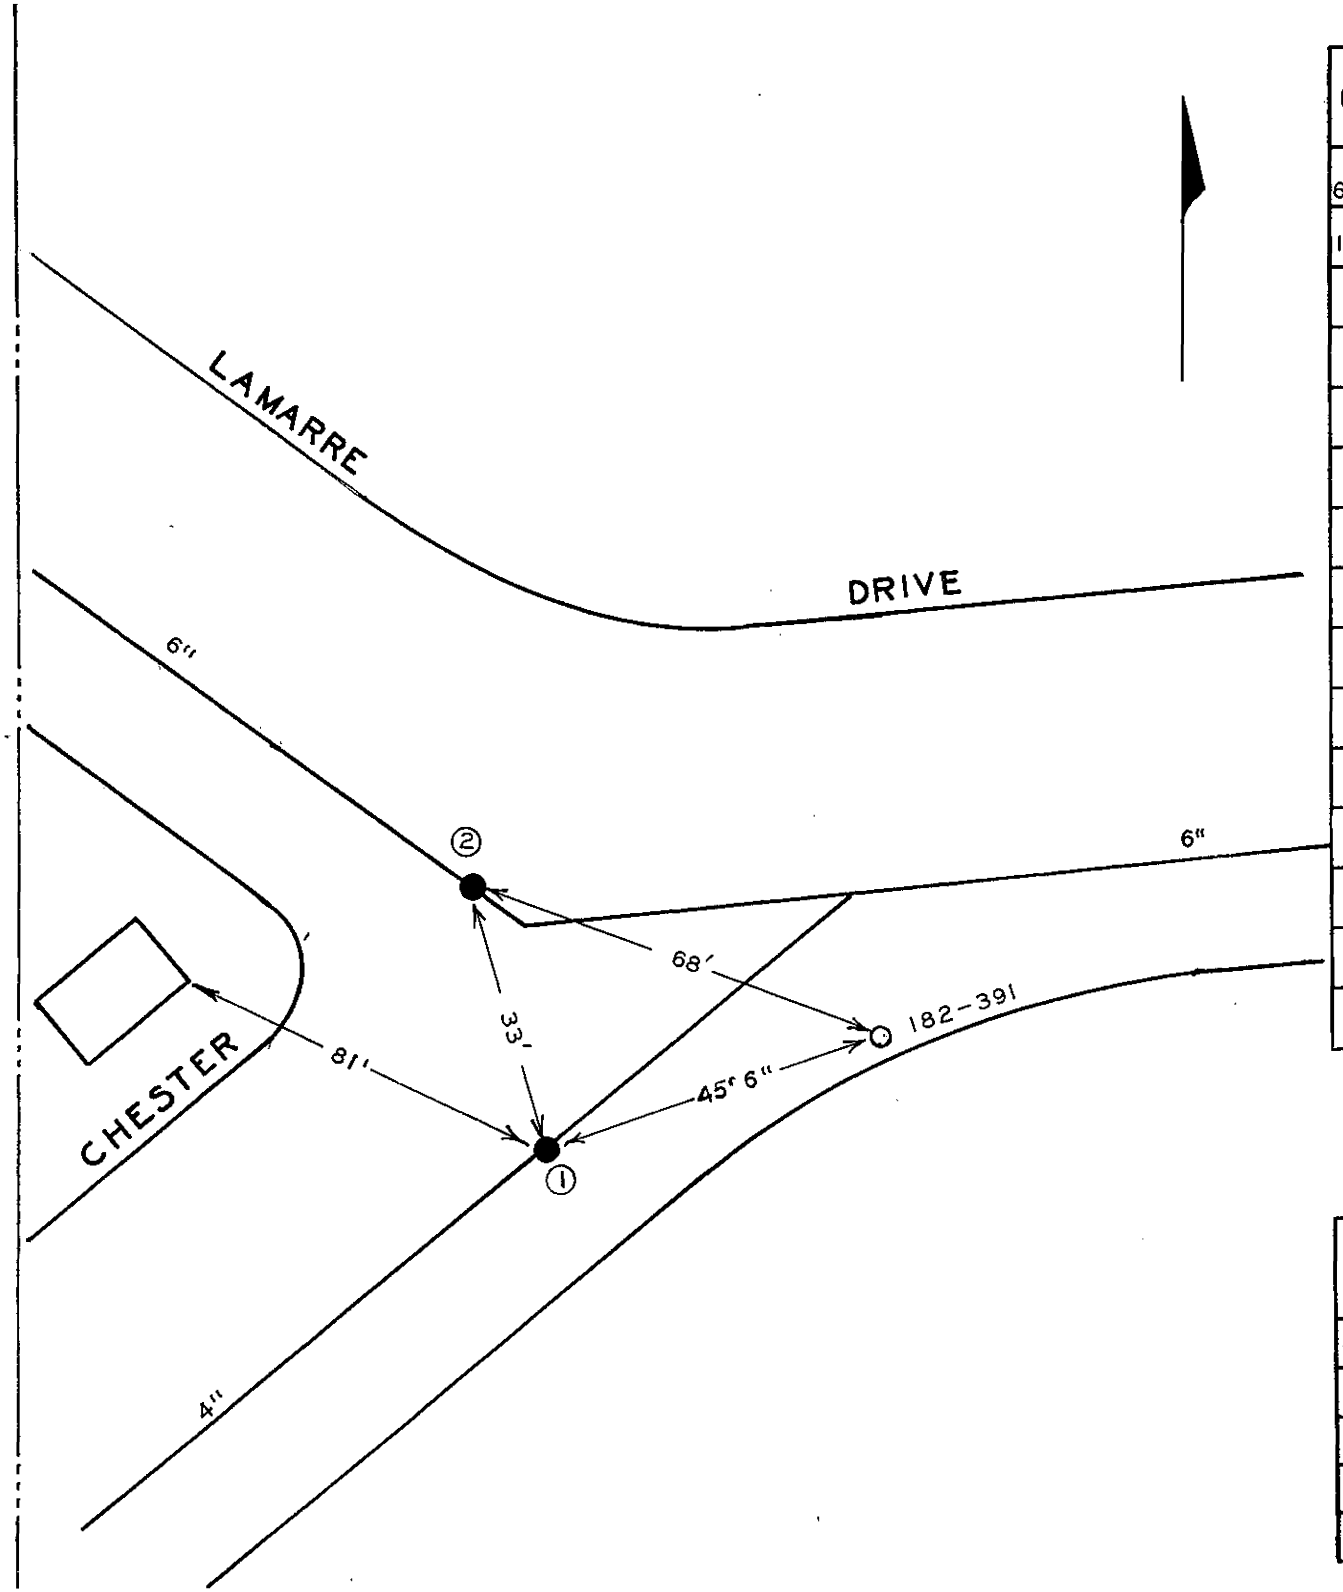

DATE	NO.	SIZE	MAKE	OPEN	TURNS
6650	1	4"	MUELLER	L	11
10-68	2	6"	MUELLER	R	21

CITY OF ROANOKE—WATER DEPT.

VALVE DIAGRAM

CHESTER AVENUE &

LA MARRE DRIVE N.E.

SEC. MAP 58 Roanoke County

DATE PAGE NO.