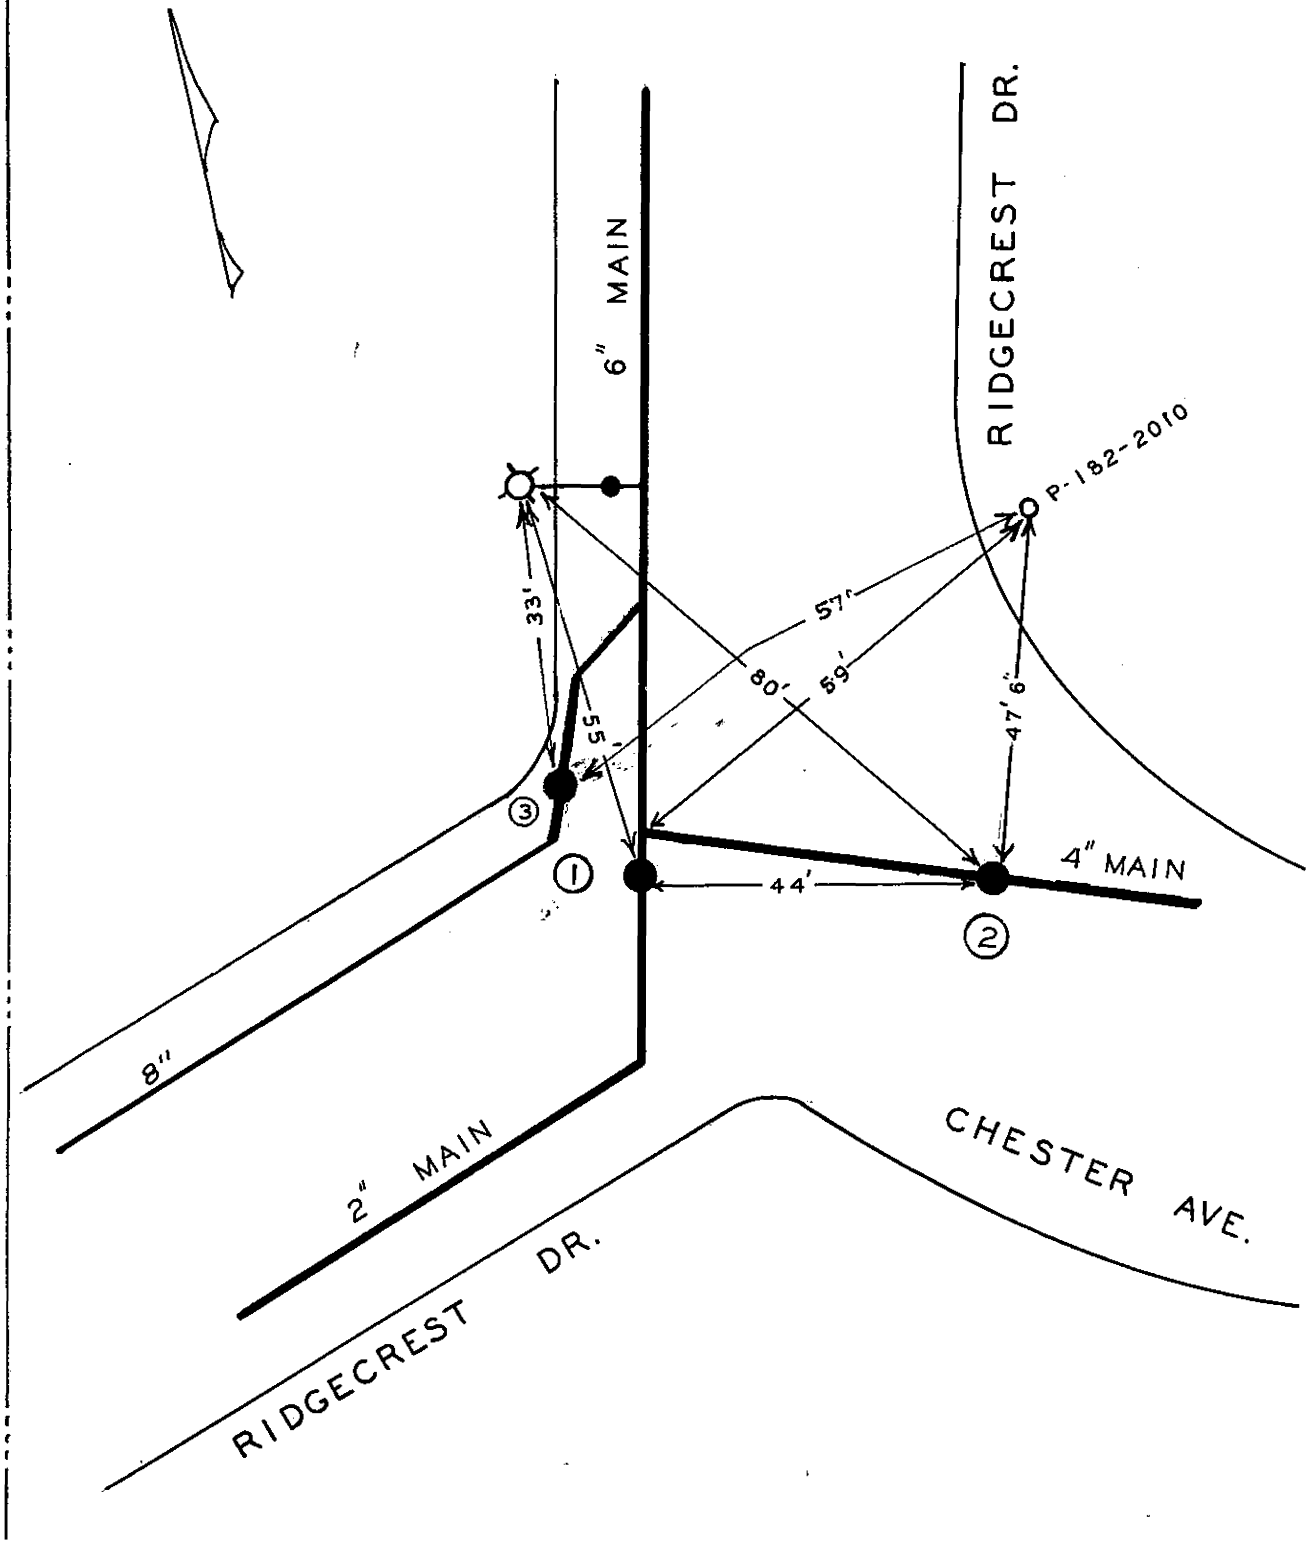

DATE	NO.	SIZE	MAKE	OPEN	TURNS
9-7-66	1	2"	MISC.		
9-7-66	2	4"	MV.	L	11
7-67	3	8	MUELLER	R	27

CITY OF ROANOKE—WATER DEPT.

VALVE DIAGRAM

CHESTER AVENUE &

RIDGECREST DR. N.E.

SEC. MAP 59 Roanoke County

DATE 9-7-66 **PAGE NO.**